


T.6S.R.1E.W.M.

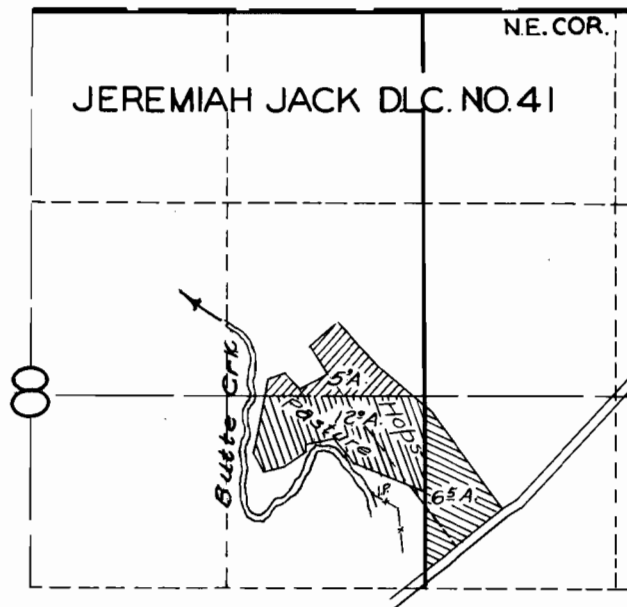

FINAL PROOF SURVEY

UNDER

Application No. 17473 Permit No. 13184

IN NAME OF

MRS. ANTOINETTE VANDERBECK

Surveyed MAY 11 1949, by H.L. COFFMAN