


**T.28S. R.12W.W.M.**

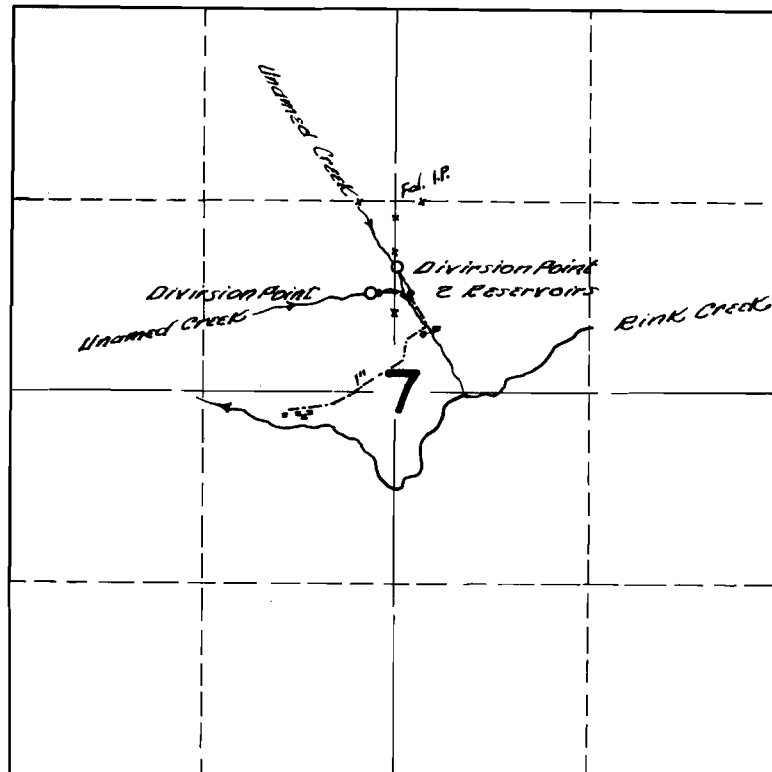

**FINAL PROOF SURVEY**  
UNDER

Application No. **20542** Permit No. **16070**...  
IN NAME OF

**JAMES A. PORTER & ELMER CUNNINGHAM**  
& **ELMER BENHAM**

Surveyed **SEPT. 16 1949.**, by **H.L. COFFMAN.**