


T.3S.R.2W.W.M.

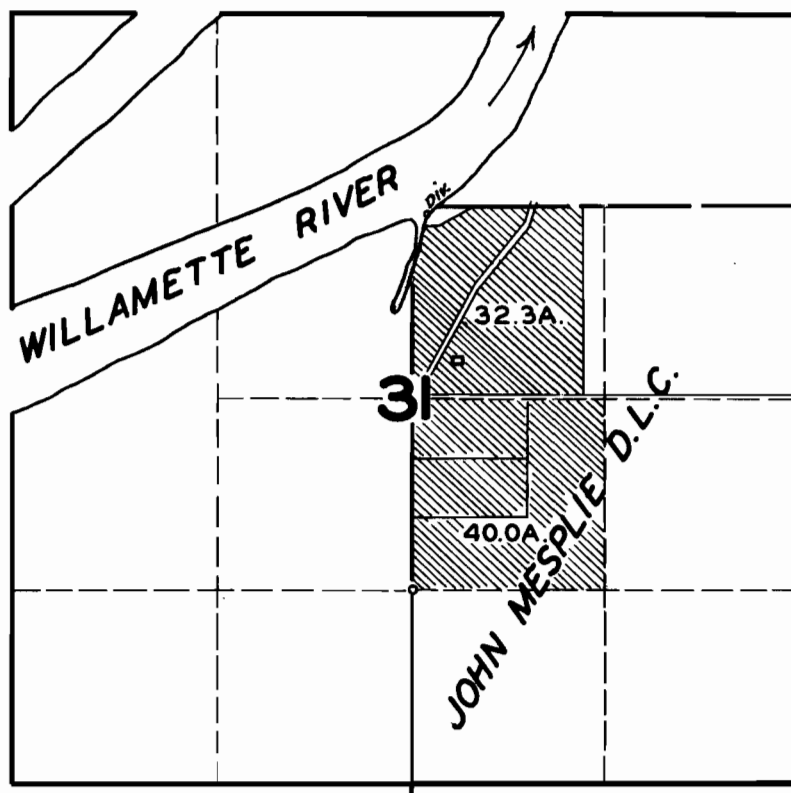

FINAL PROOF SURVEY
UNDER

Application No. **20711** Permit No. **16193**
IN NAME OF

JOHN P. Mc CARTHY

Surveyed **APR. 20 1948**, by **JAS. E. BUNNELL**