


33
4

TOWNSHIP ³⁴⁵355, RANGE 1W, W. M.

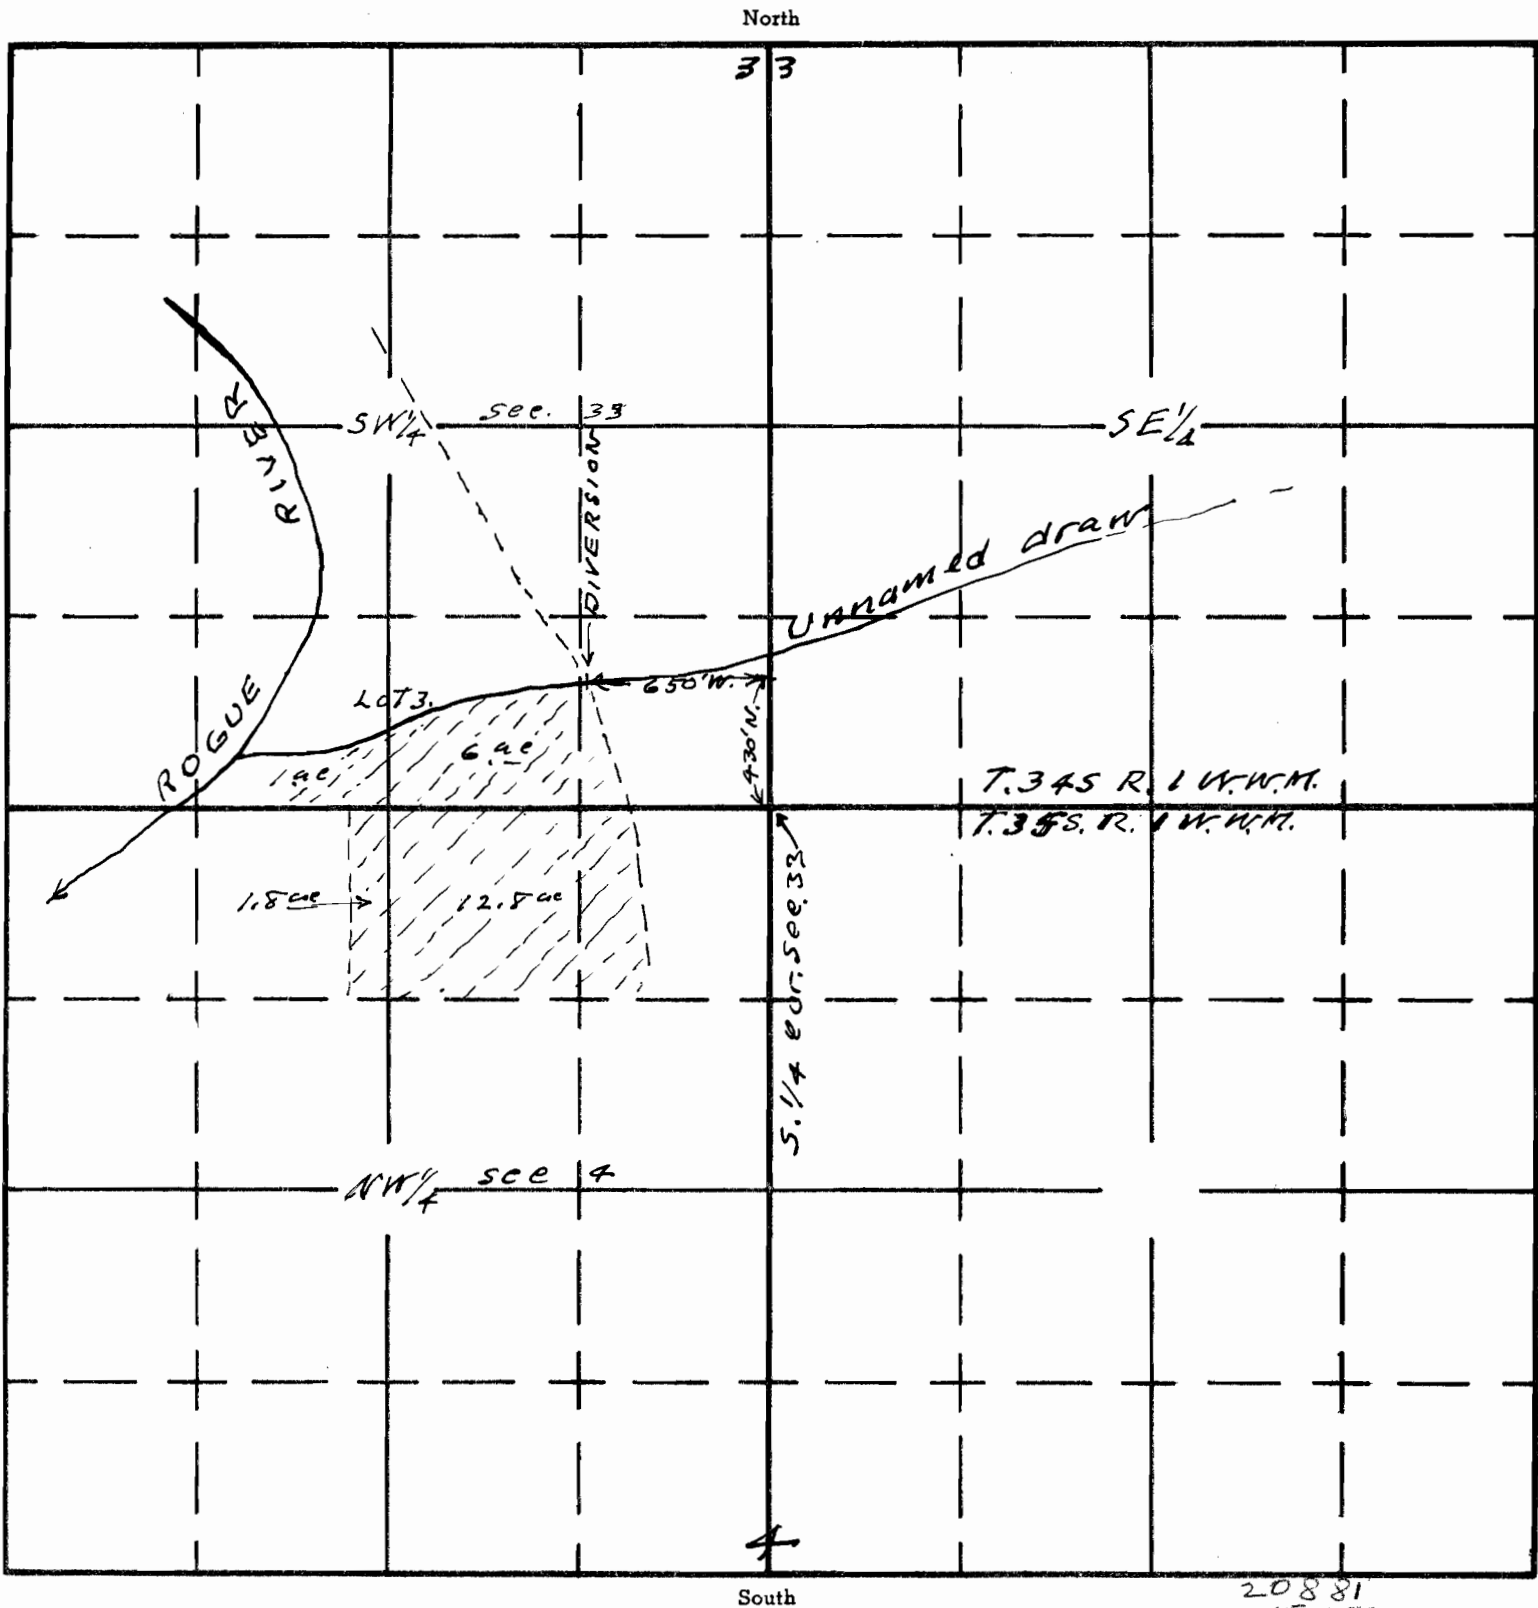

Map To accompany application of Virginia Katherine McMath Briggs known as Ginger Rogers for use of waters of Unnamed draw for irrigation purposes.

20881
15-780

This office 9/25/45

Application No. 20881
Permit No. 16355