


T.41S.R.13W.W.M.

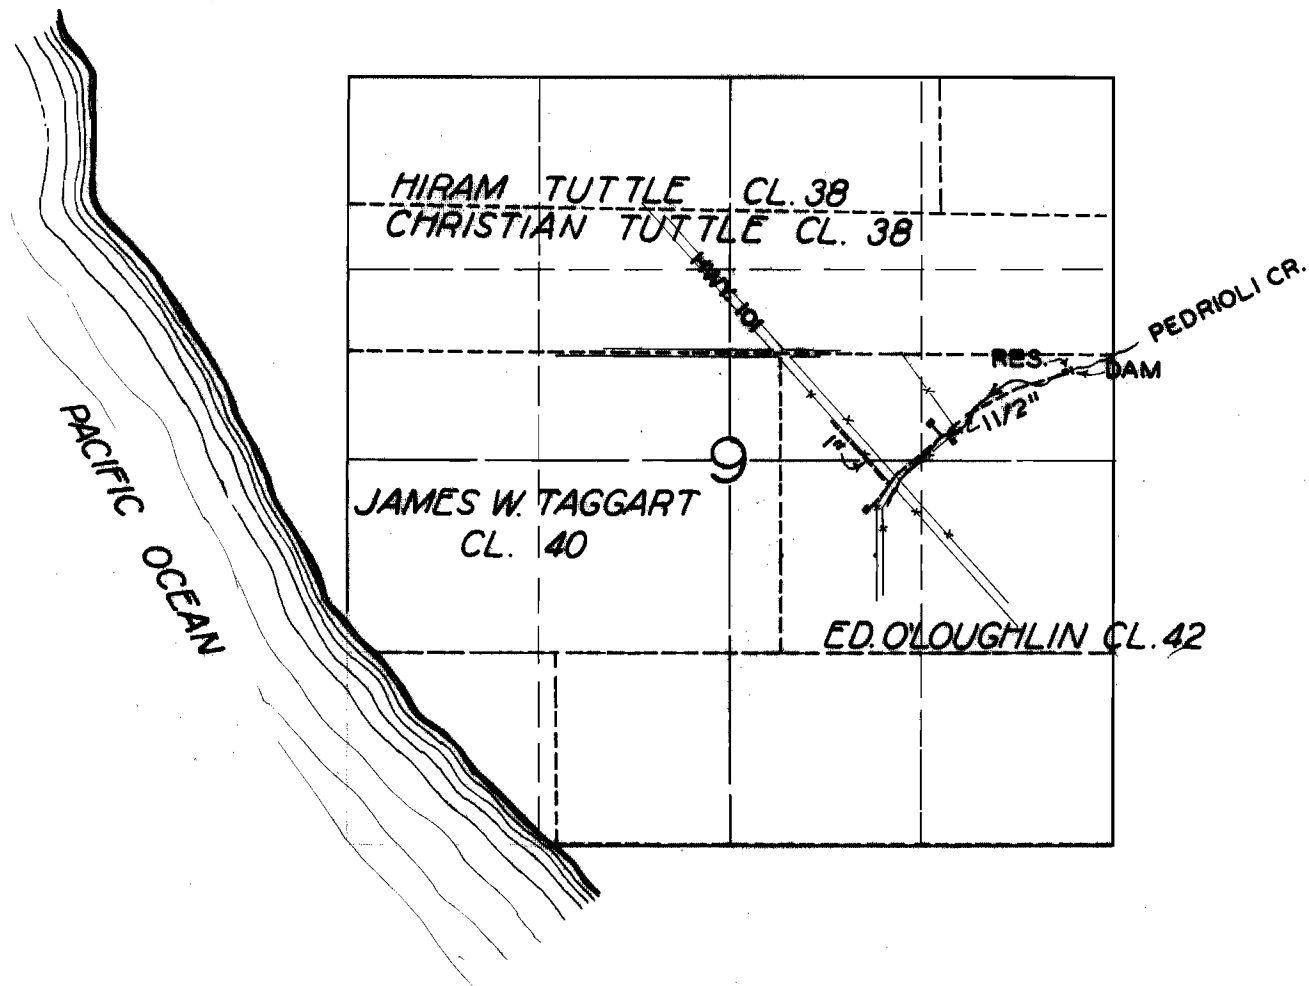

FINAL PROOF SURVEY

UNDER

Application No. 20900. Permit No. 16367.
IN NAME OF

.....ANDREW POTOENICK.....

Surveyed AUG. 4. 1949., by H.L. COFFMAN.