


SECTION

16423
17301

14
15
22

TOWNSHIP 38 S, RANGE 3 E, W. M.

North

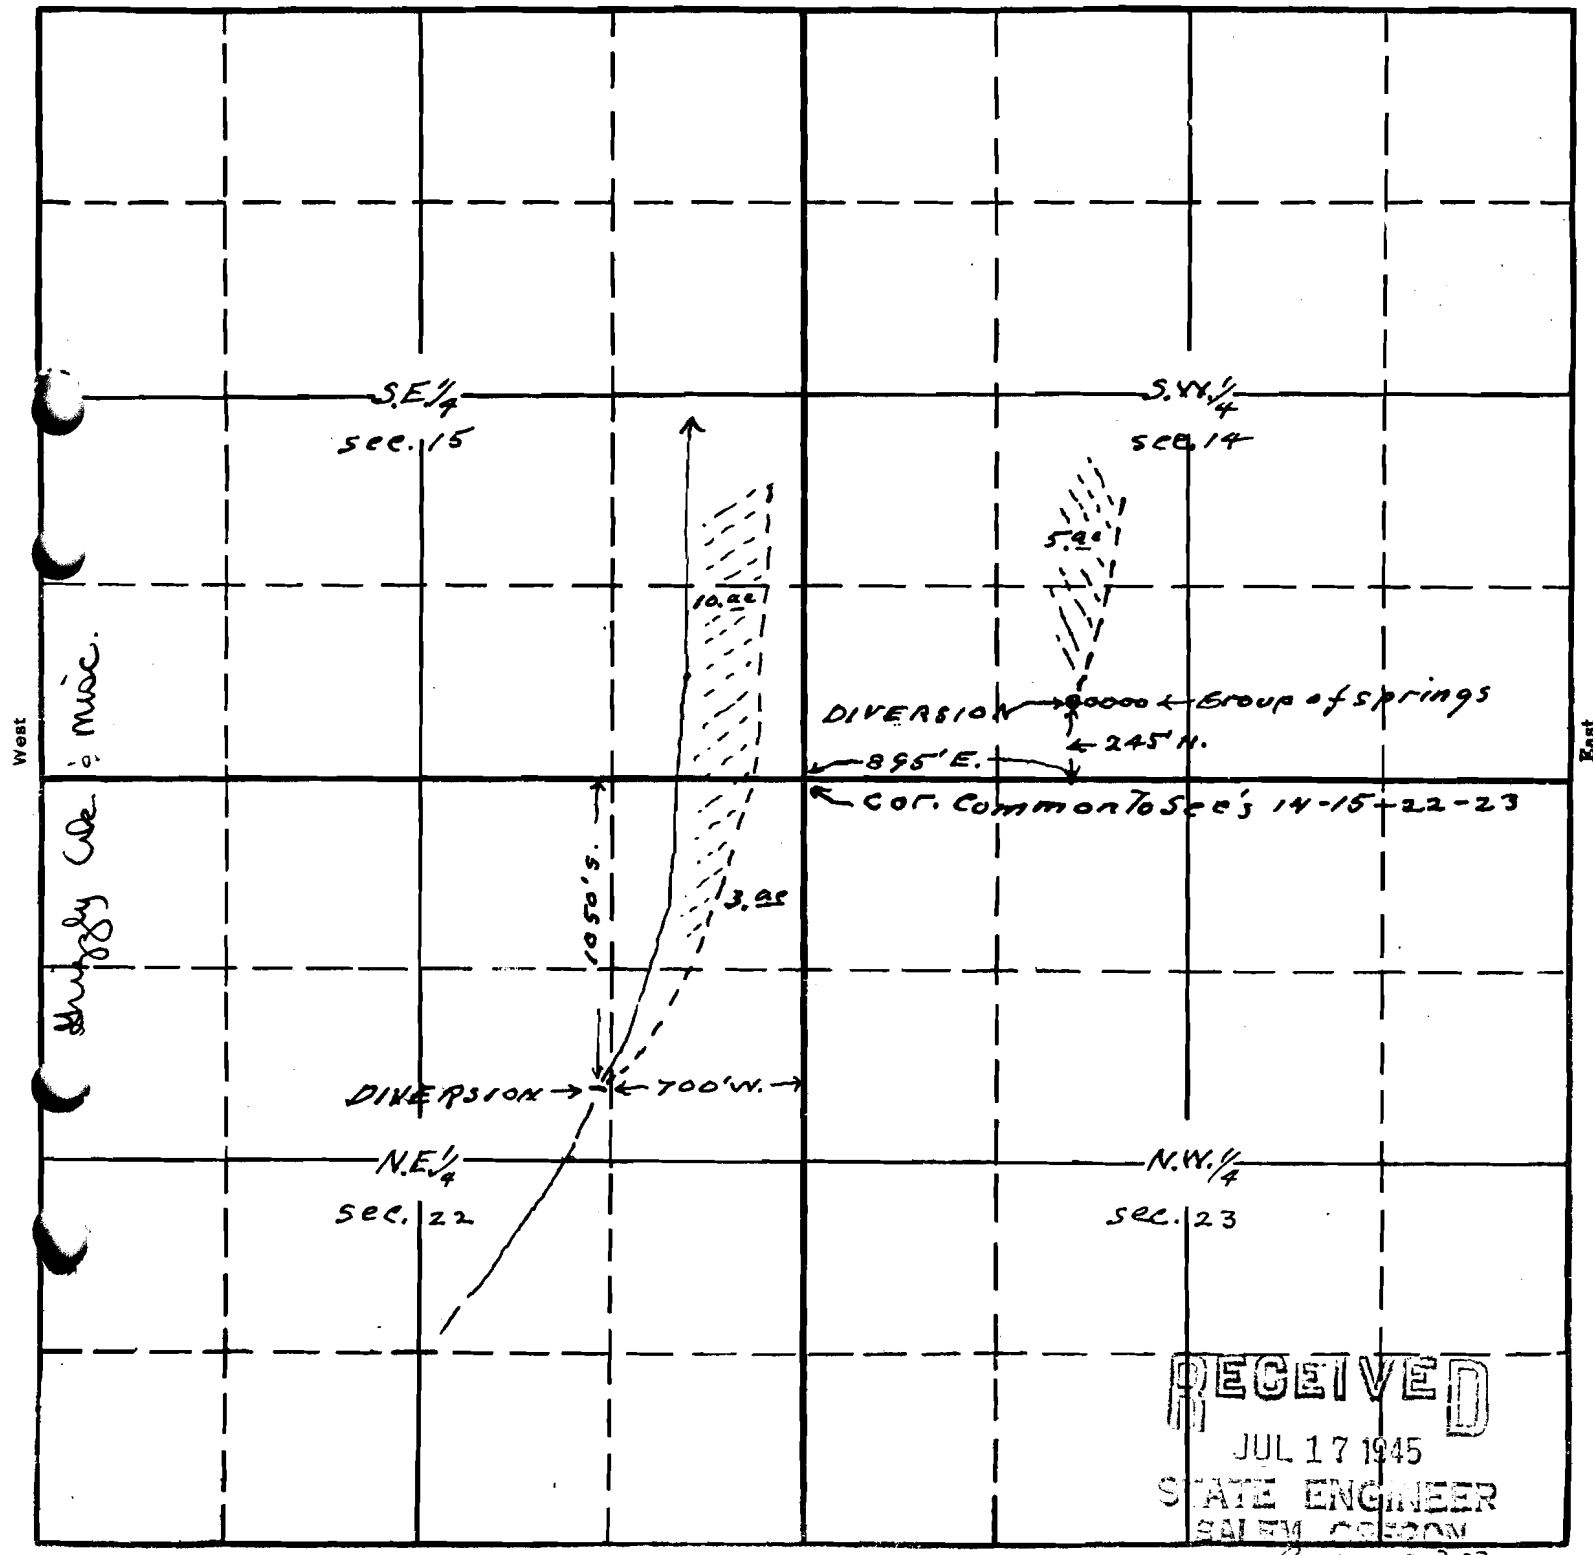

RECEIVED
 JUL 17 1945
 STATE ENGINEER
 SALEM OREGON

R-20980
 74-4
 APPLICATION No. 20981
 PERMIT No. 16423

Map To accompany application of
 L.W. Tame for use of waters from
 unnamed stream, three step reservoirs,
 and group of springs for irrigation purposes.

South