


**T.28S.R.6W.W.M.**

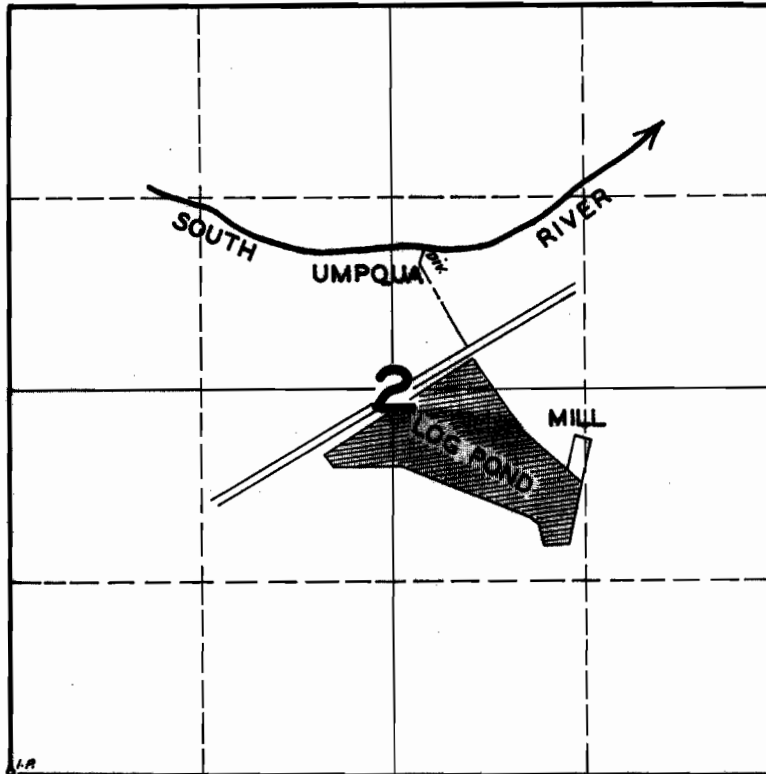

**FINAL PROOF SURVEY**

**UNDER**

**R-21011 R-822**  
**Application No. 21012 Permit No. 16477**

**IN NAME OF**

**UMPQUA PLYWOOD CORPORATION**

**Surveyed JUNE 2 1947, by JAS. E. BUNNELL**