


T.26S.R.13W.W.M.

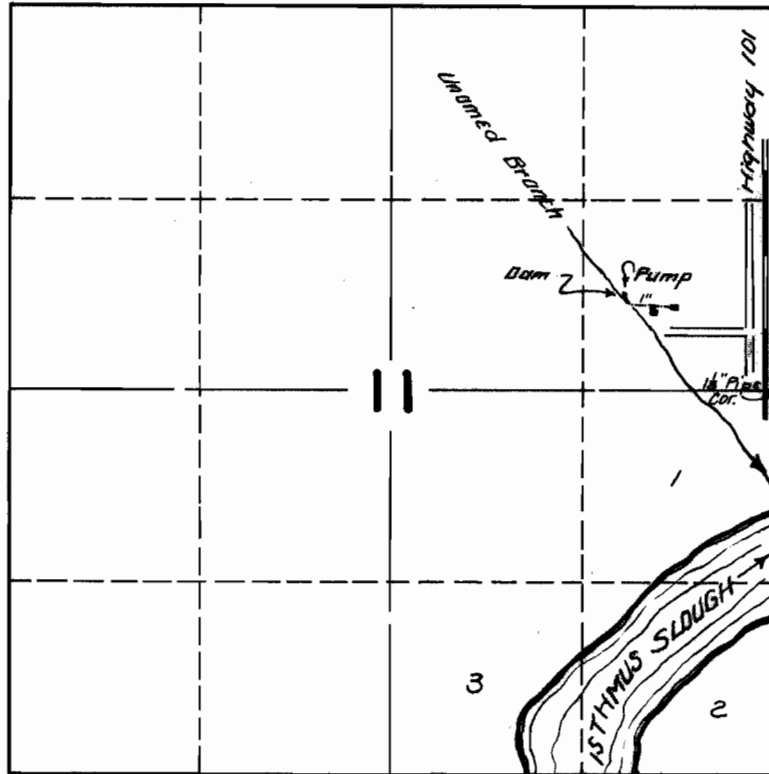

FINAL PROOF SURVEY
UNDER

Application No. 21053.. Permit No. 16497..
IN NAME OF

.....K.E. MOLITOR.....

Surveyed AUG.26. 1949, by H.L. COFFMAN..