T.28S. R.14W.W.M.

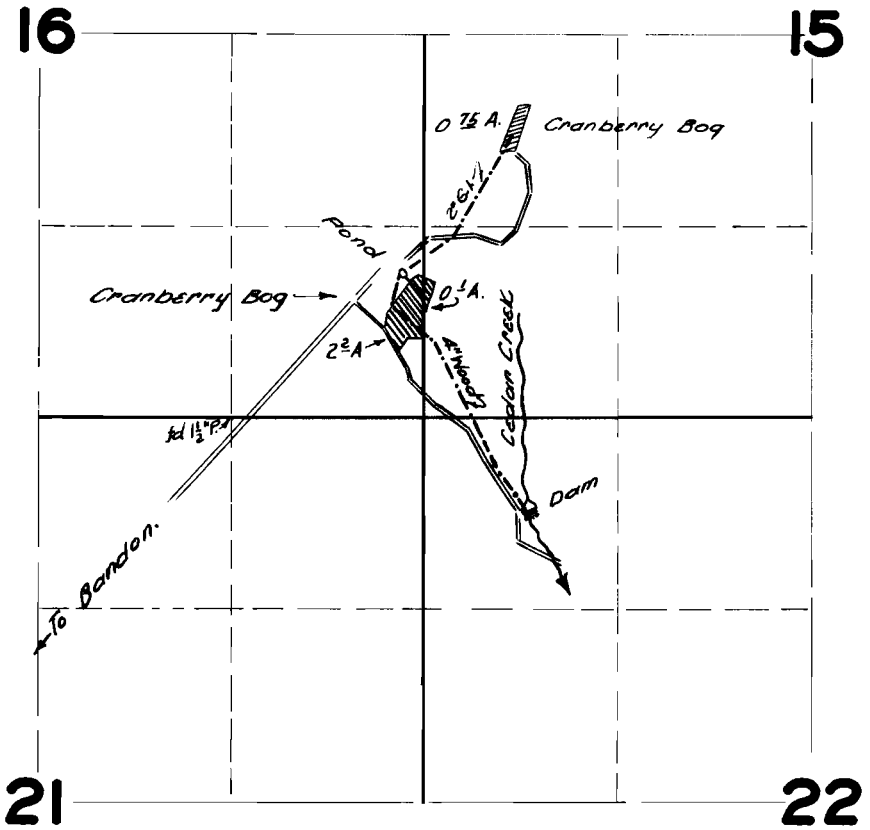

FINAL PROOF SURVEY

UNDER

Application No. 19618 Permit No. 15315

IN NAME OF

A.B. WILSON & J.E. ROSE

Surveyed SEPT. 20 1949, by H.L. COFFMAN.

1949 F