


T.17S.R.3W.W.M.

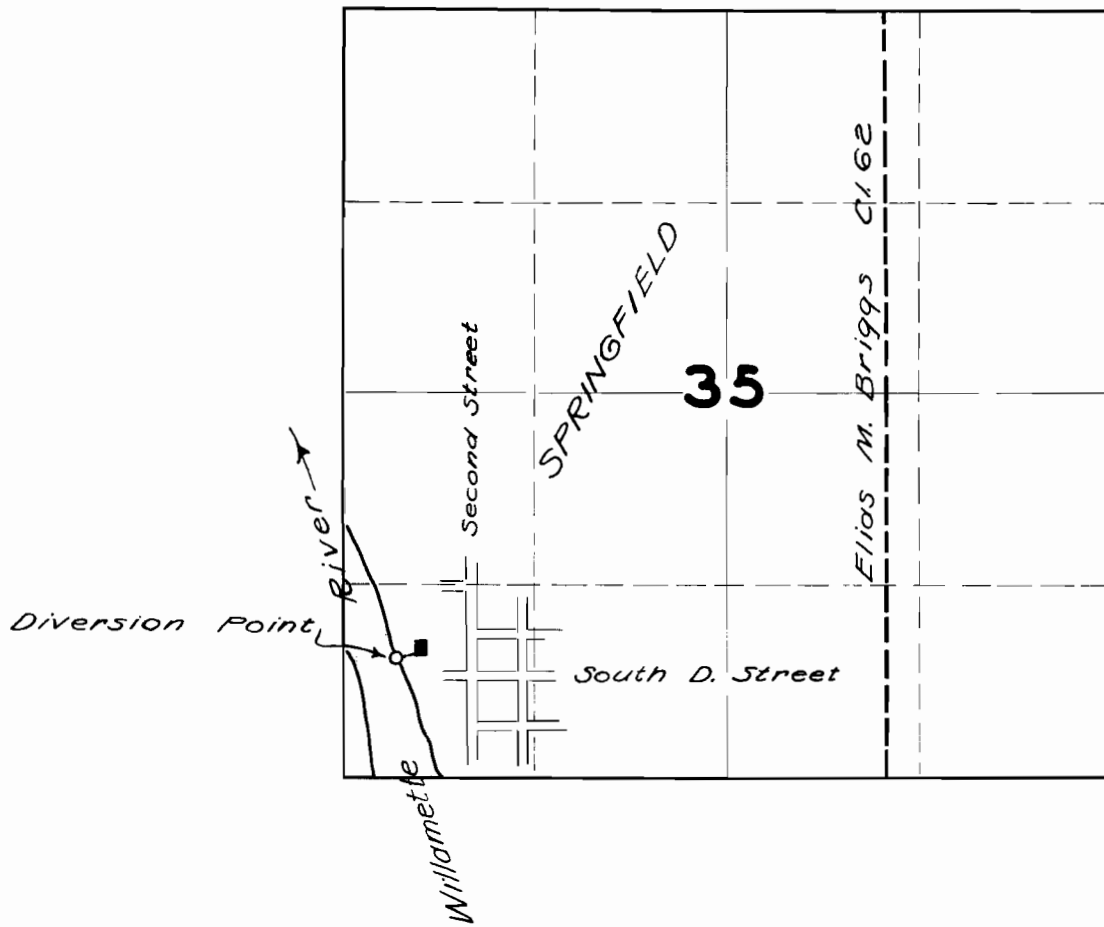

FINAL PROOF SURVEY

UNDER

Application No. 21240.. Permit No. 16647..



IN NAME OF

THE BORDEN CO. CHEMICAL DIVISION.....


Surveyed 19....., by

WATER APPLICATION MAP.
 BY
 THE CASEIN COMPANY OF AMERICA
 DIVISION OF BORDEN COMPANY.
 SPRINGFIELD, OREGON.

R 3 W W.M.

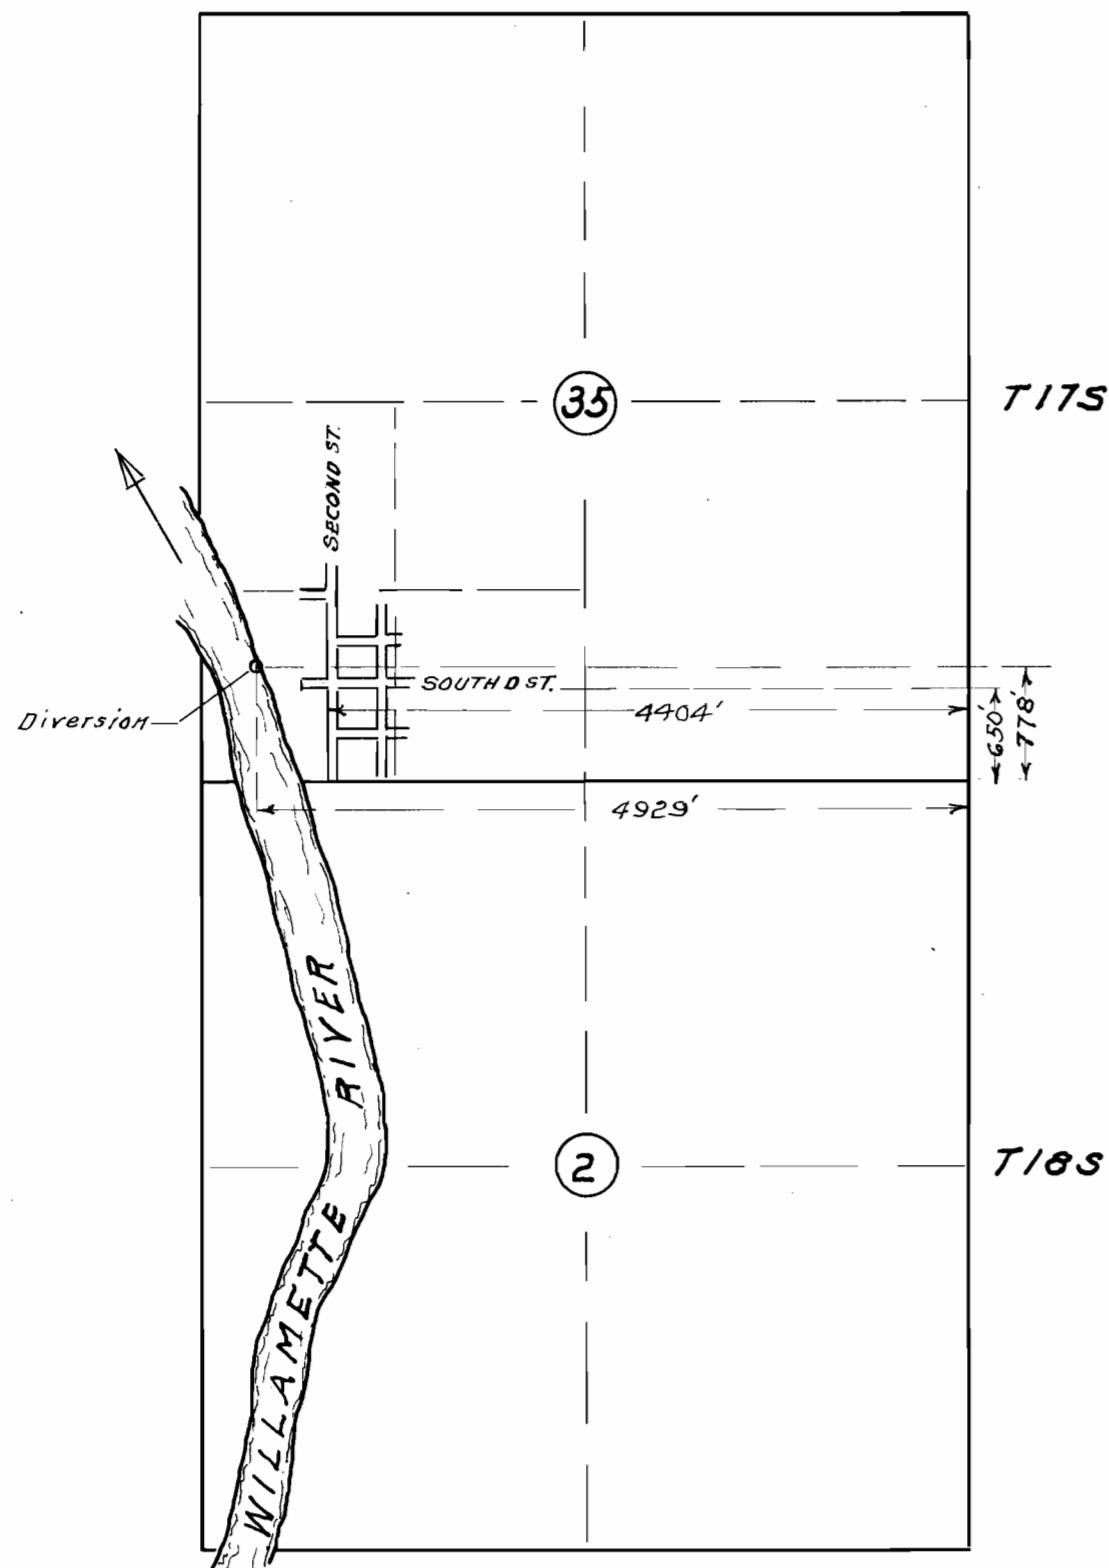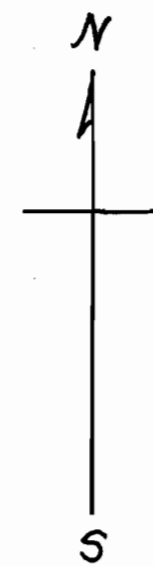

1 mile = 4"

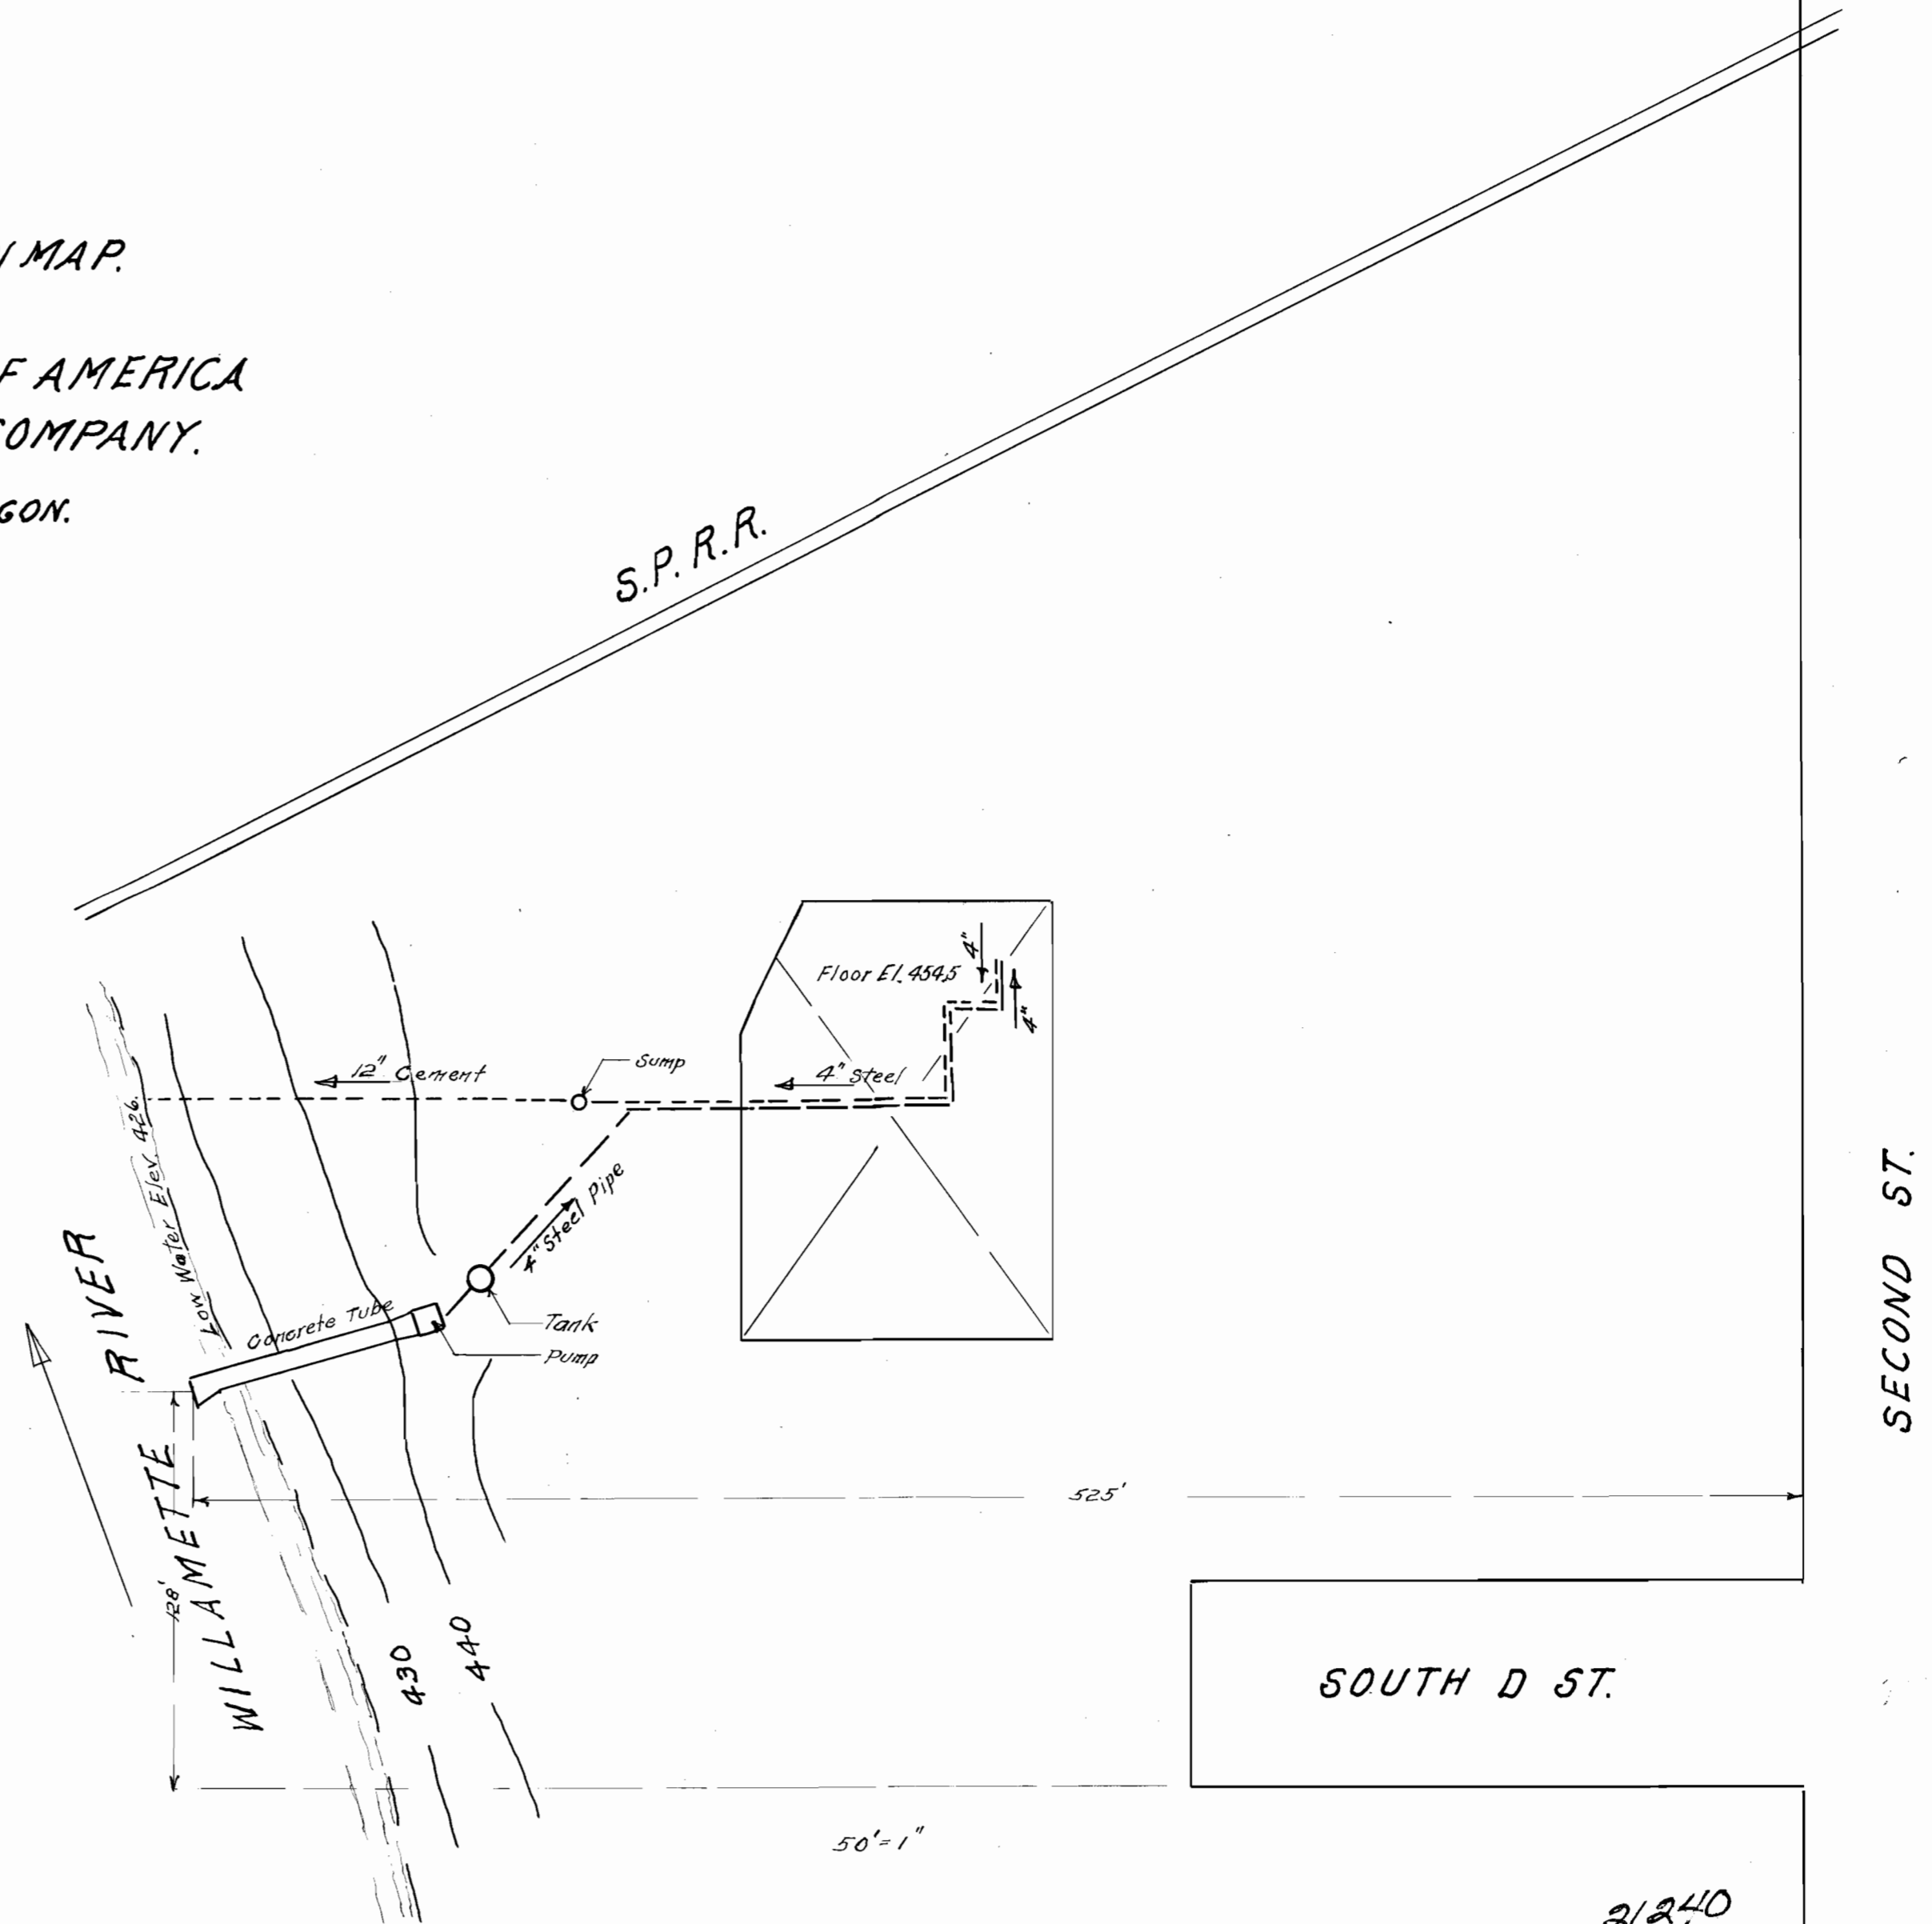

SOUTH D ST.

SECOND ST.

21240
 16617