


T.17S.R.2W.W.M.

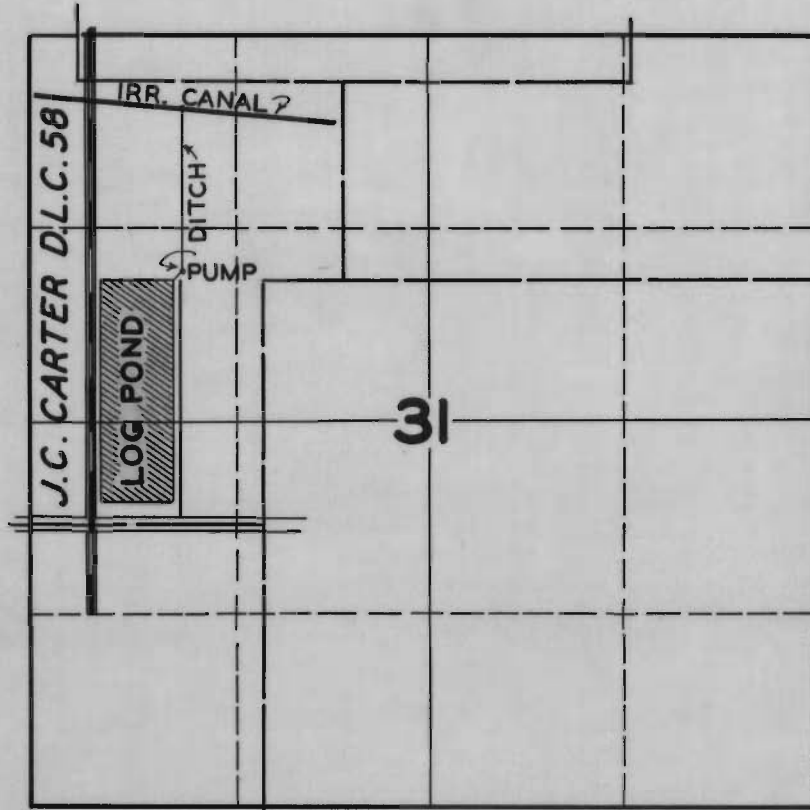

MAP NO. 1 OF 2

FINAL PROOF SURVEY

UNDER

R-20029

R-782

Application No. 20030 Permit No. 15600

IN NAME OF

WEST OREGON LUMBER COMPANY

Surveyed AUG. 5, 1947, by JAS. E. BUNNELL

T.17S.R.1W.W.M.



MAP NO. 2 OF 2

FINAL PROOF SURVEY

UNDER

R-20029

R-7812

Application No. 20030 Permit No. 15600

IN NAME OF

WEST OREGON LUMBER COMPANY

Surveyed JUNE 22 1948, by JAS. E. BUNNELL