


T.25S.R.5W.W.M.

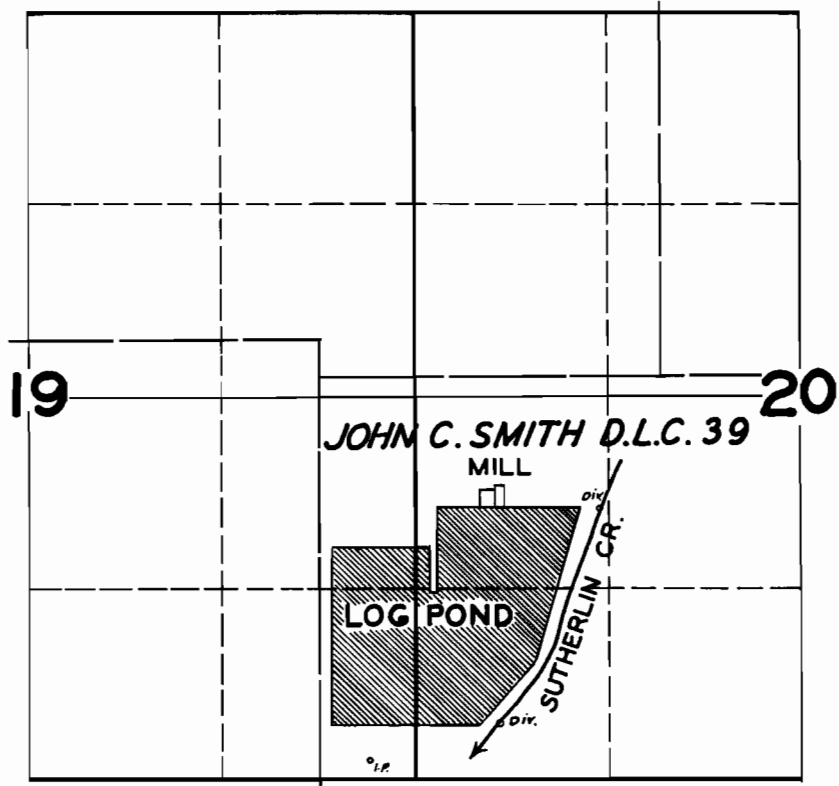

FINAL PROOF SURVEY

UNDER

R-20341

R-875

Application No. 20342 Permit No. 17686

IN NAME OF

SUTHERLIN TIMBER PRODUCTS, INC.

Surveyed JULY 7, 1947, by JAS. E. BUNNELL