


T.25 S.R.1 I.W.W.M.

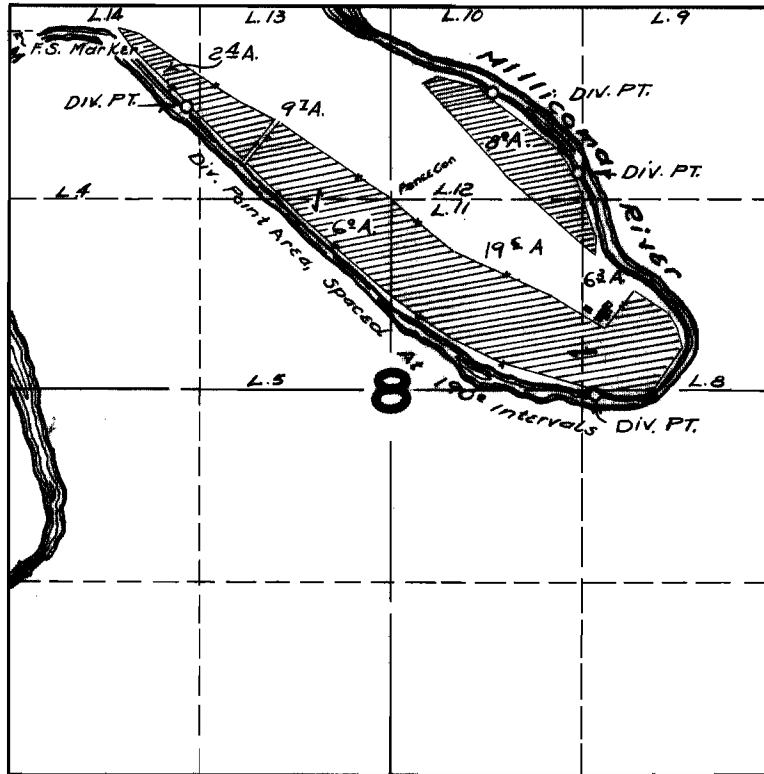

FINAL PROOF SURVEY

UNDER

Application No. 21027.. Permit No. 16448.

IN NAME OF

.....HERMAN F. HEEP.....

Surveyed AUG. 31. 1949., by H.L. COFFMAN..