


28

32

TOWNSHIP 38S, RANGE 3W, W. M.

North

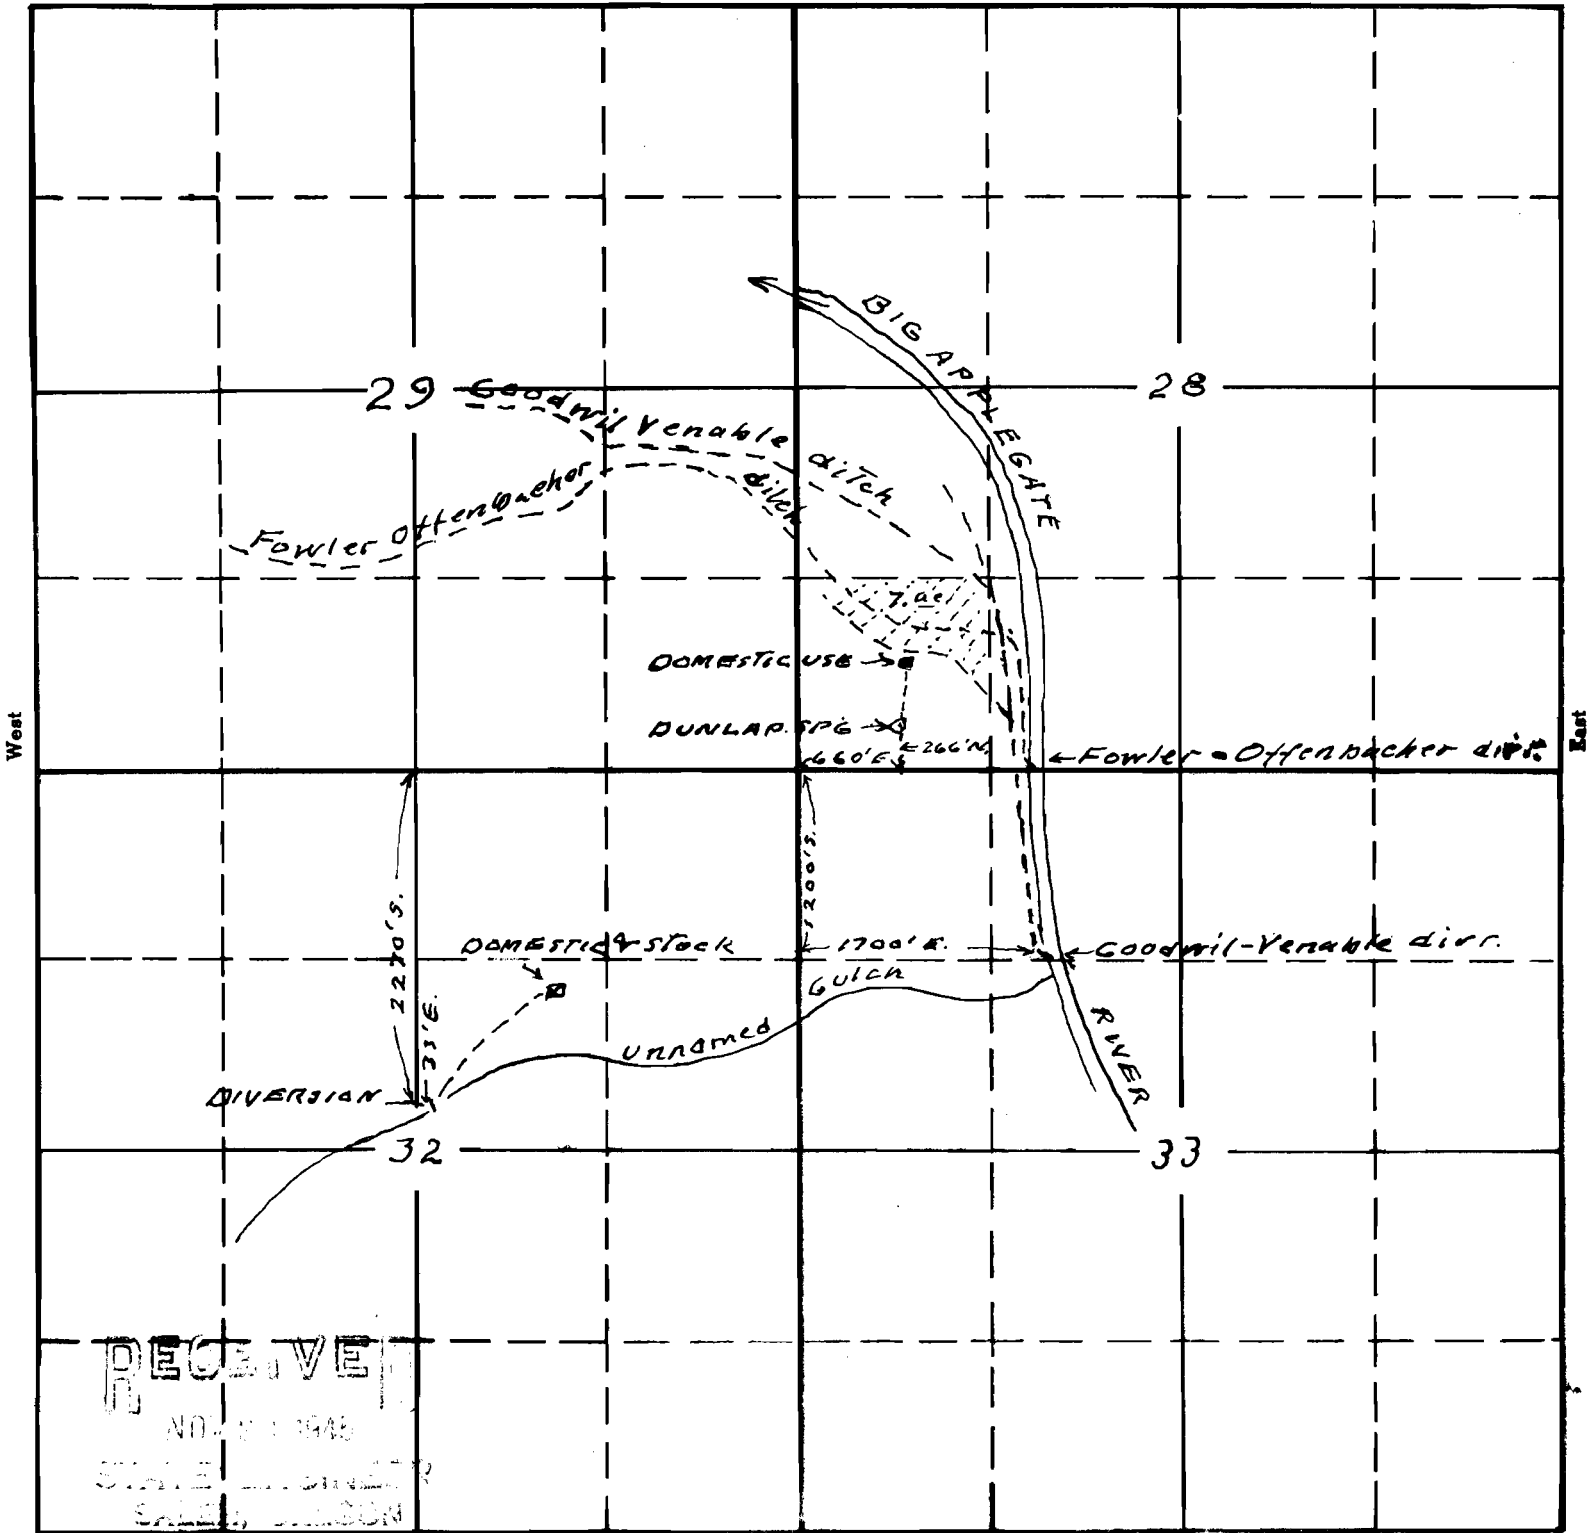

South

Map to accompany application of Marion Dunlap for use of waters of Big Applegate River, Dunlap spring, and unnamed Gulch for irrigation, domestic and stock purposes.

21296
15-8A6C
APPLICATION No. 21296
PERMIT No. 6699

This office 11/20/45 *[Signature]*