T. 41 S. R. 13 W. W. M.

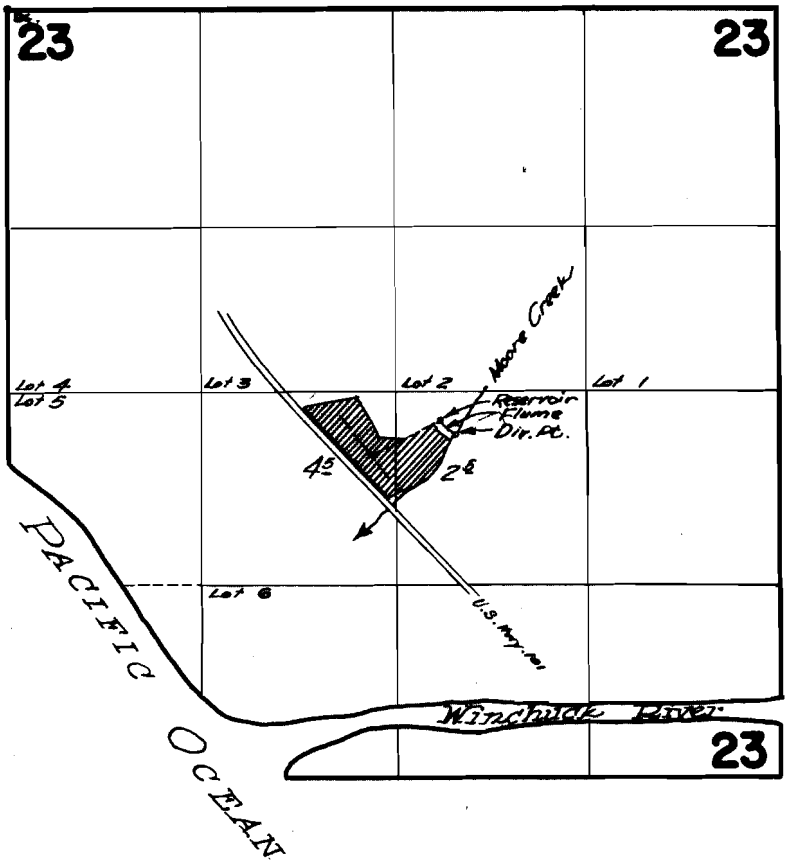

FINAL PROOF SURVEY
UNDER

Application No. 21369 Permit No. 16741
IN NAME OF

GRANT M. & MAY POWELL

Surveyed August 10. 1949., by H.L. Coffman.

1949-C

Survey of adjoining right (A-30475) indicates this may haywire, so redrafted to conform to other work in the area. These jobs all tied together on 1965-A.
RF

3W.W.M.

Superceded

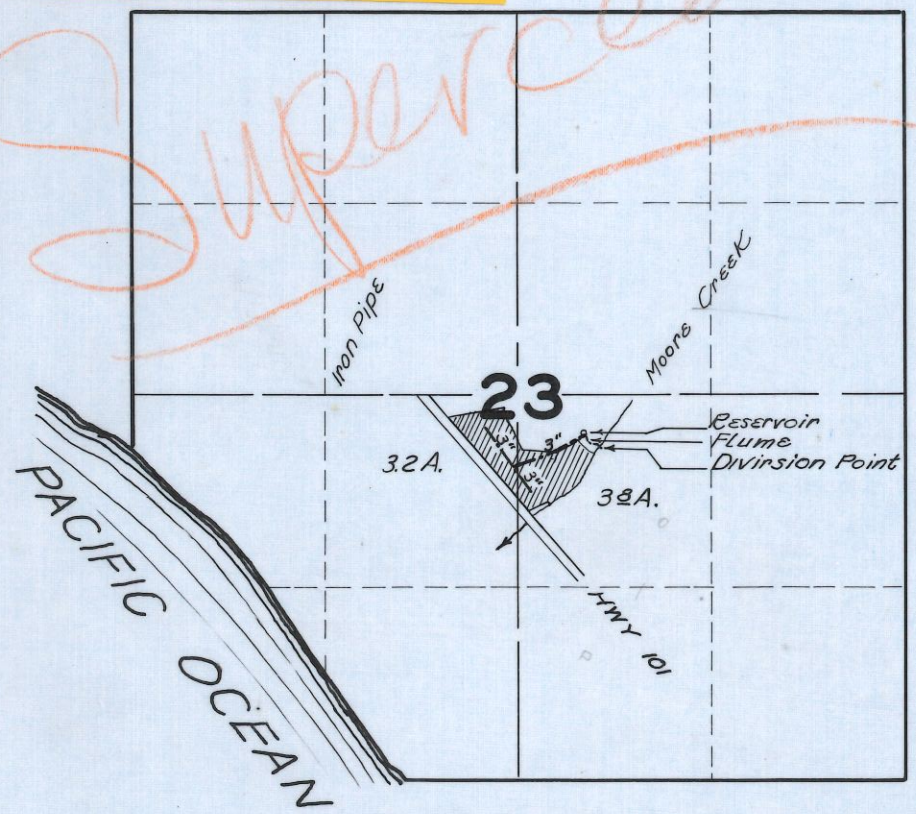

FINAL PROOF SURVEY

UNDER

Application No. 21369 Permit No. 16741

IN NAME OF

GRANT M. & MAY POWELL

Surveyed AUG. 10. 1949., by H.L. COFFMAN

1949 E