


T.41S.R.13W.W.M.

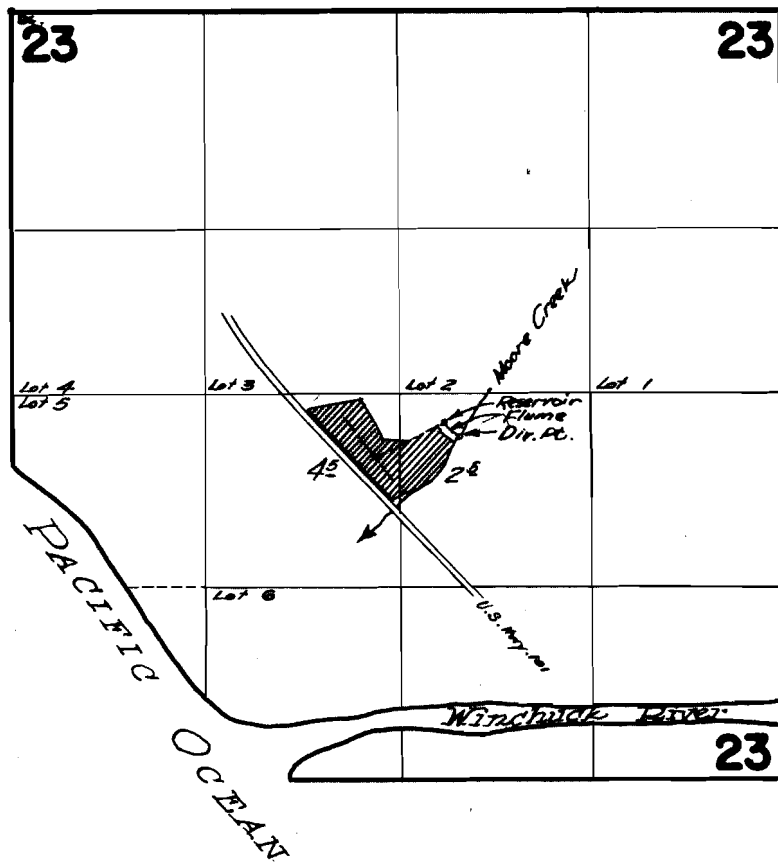

FINAL PROOF SURVEY UNDER

Application No. 21369... Permit No. 16741.....
IN NAME OF

GRANT M. & MAY POWELL

Surveyed August 10, 1949, by H.L. Coffman.