


T.26S.R.7W.W.M.
MELROSE ORCHARDS

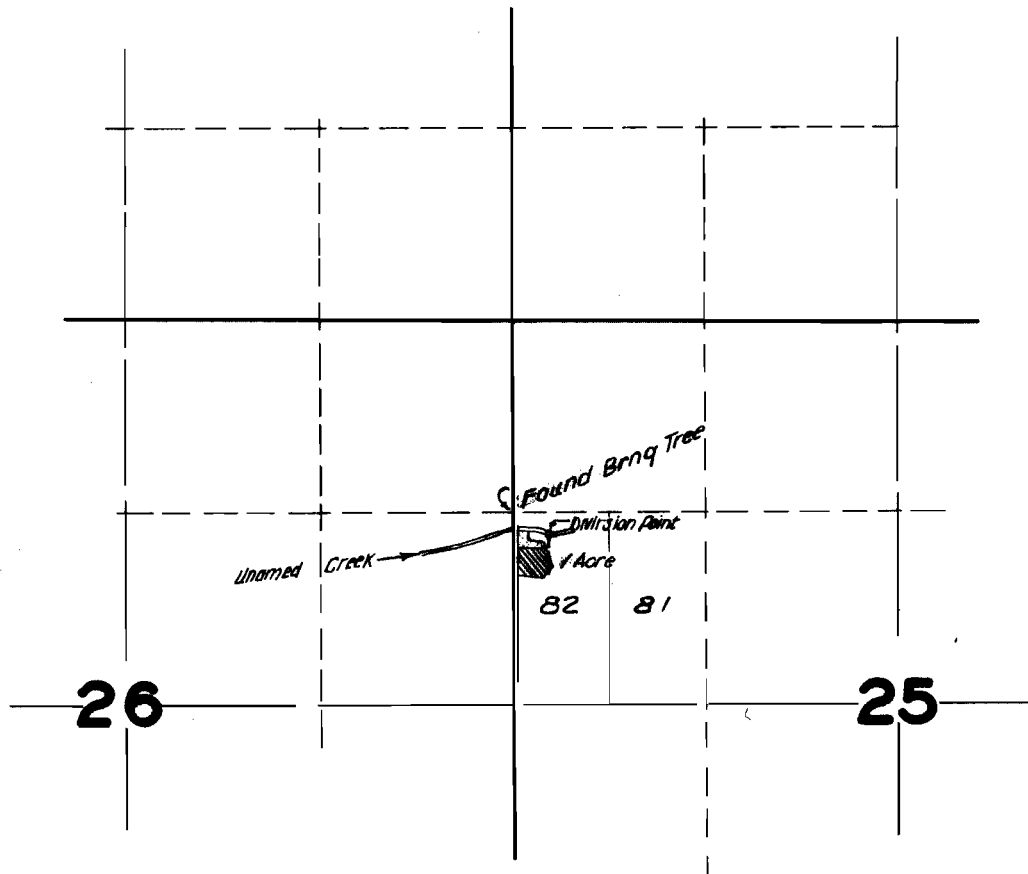

FINAL PROOF SURVEY
UNDER

Application No. ~~21515~~..... Permit No. ~~16872~~..
IN NAME OF

JOHN F. & ZELLA M. WELLPOTT

Surveyed 6/30..... 1949., by H.L. COFFMAN