


T.17S.R.3W.W.M.

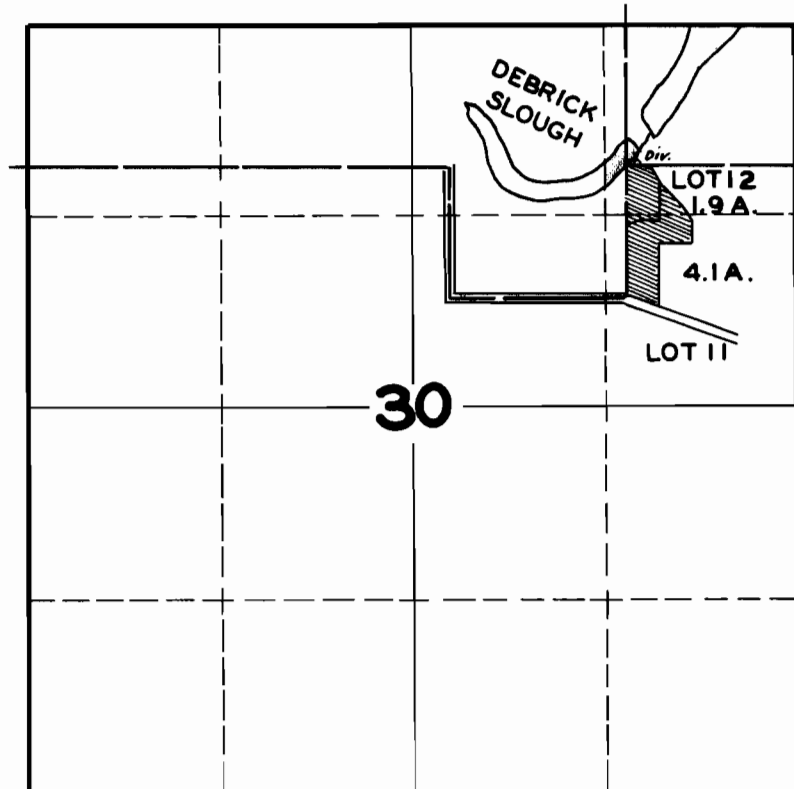

FINAL PROOF SURVEY
UNDER

Application No. 21433 Permit No. 16814

IN NAME OF

VERNON A. STEPHENS - IRENE D. STEPHENS & DR. A.H. ROSS

Surveyed AUG. 1, 1946, by JAS. E. BUNNELL