


T.27S. R.13W.W.M

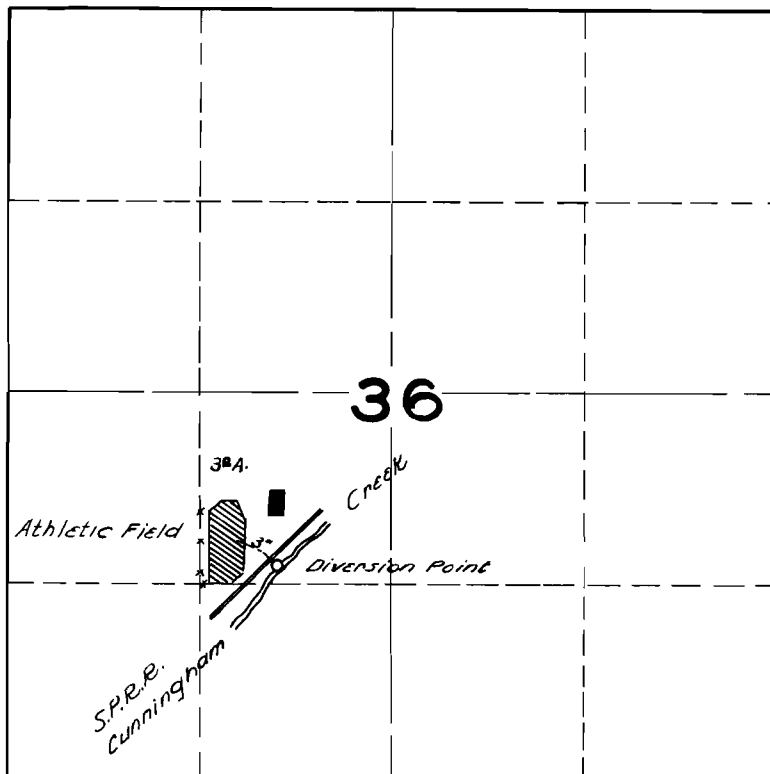

FINAL PROOF SURVEY

UNDER

Application No. **21587**... Permit No. **16963**...

IN NAME OF

SCHOOL DISTRICT NO 8

Surveyed **SEPT. 17, 1949**, by **H.L. COFFMAN**