


Per 16995
17324

T.14S.R.30 E.W.M.

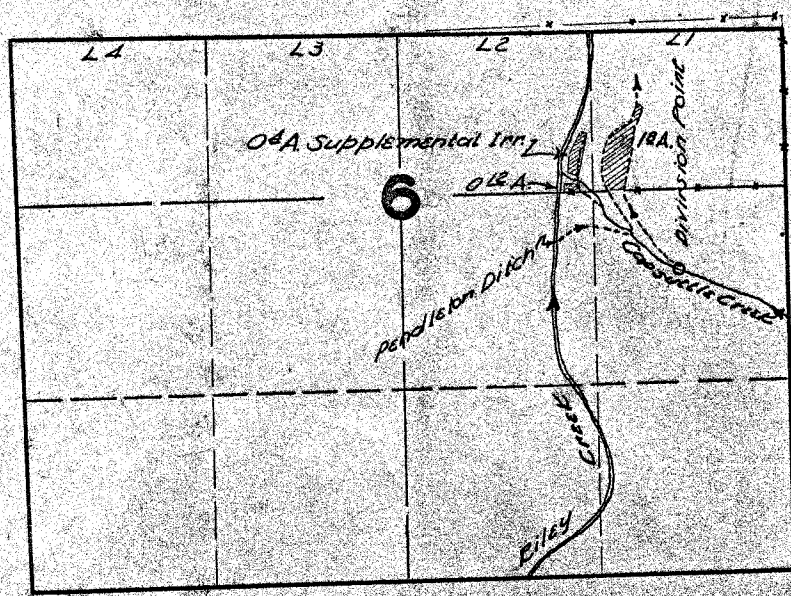

FINAL PROOF SURVEY UNDER

Application No. 21628. Permit No. 16995.
IN NAME OF

.....HENRY C. SEITZ.....

Surveyed OCT. 25 1949, by H.L. COFFMAN.