


T.16S.R.5W.W.M.

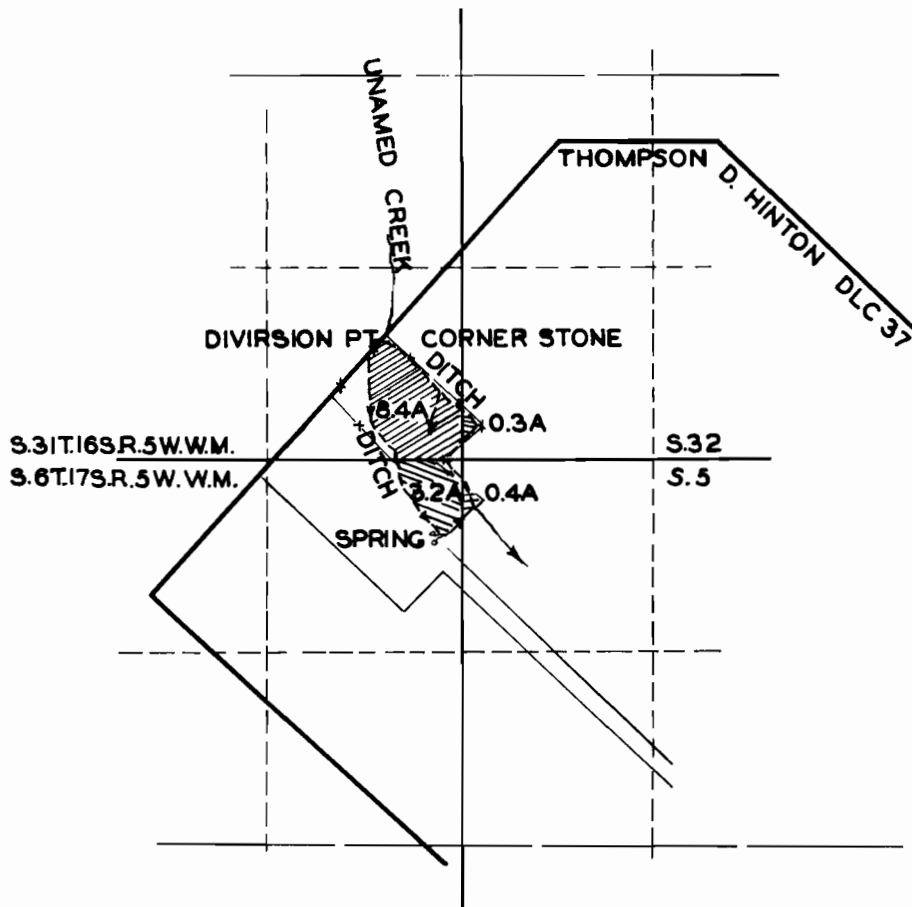

FINAL PROOF SURVEY

UNDER

Application No. 21794 . Permit No. 17147...

IN NAME OF

..... EDWARD A. GENT

Surveyed .MAY 27 1949., by .H.L. COFFMAN.