


T.24 S. R.3 W.W. M.

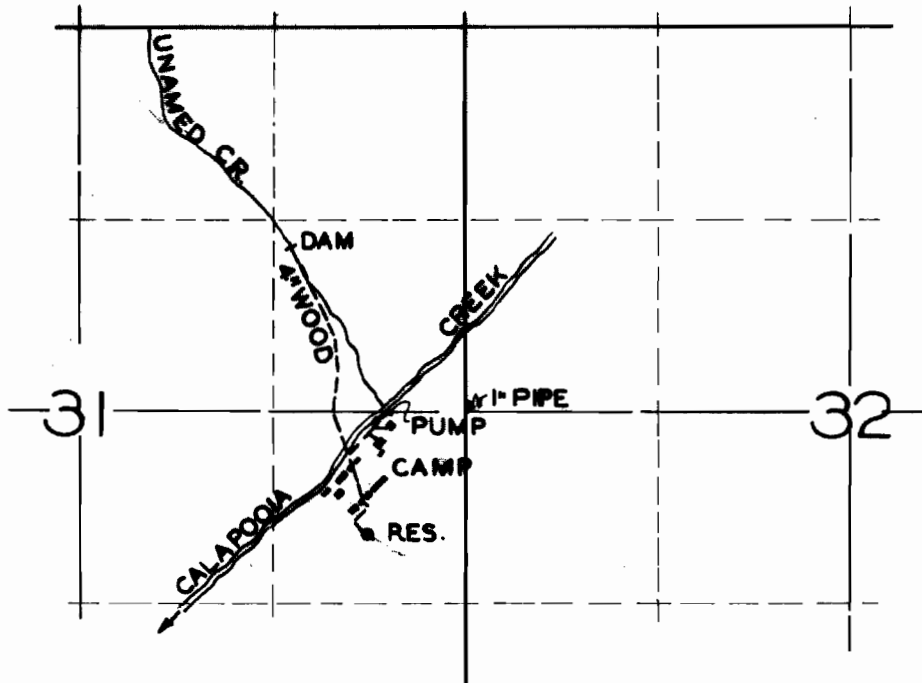

FINAL PROOF SURVEY

UNDER

Application No. 21859 Permit No. 17159
IN NAME OF

ROCK ISLAND LUMBER COMPANY

Surveyed JULY 19, 1949, by H.L. COFFMAN