


10
T.11 S. R. 26 E. W.M.

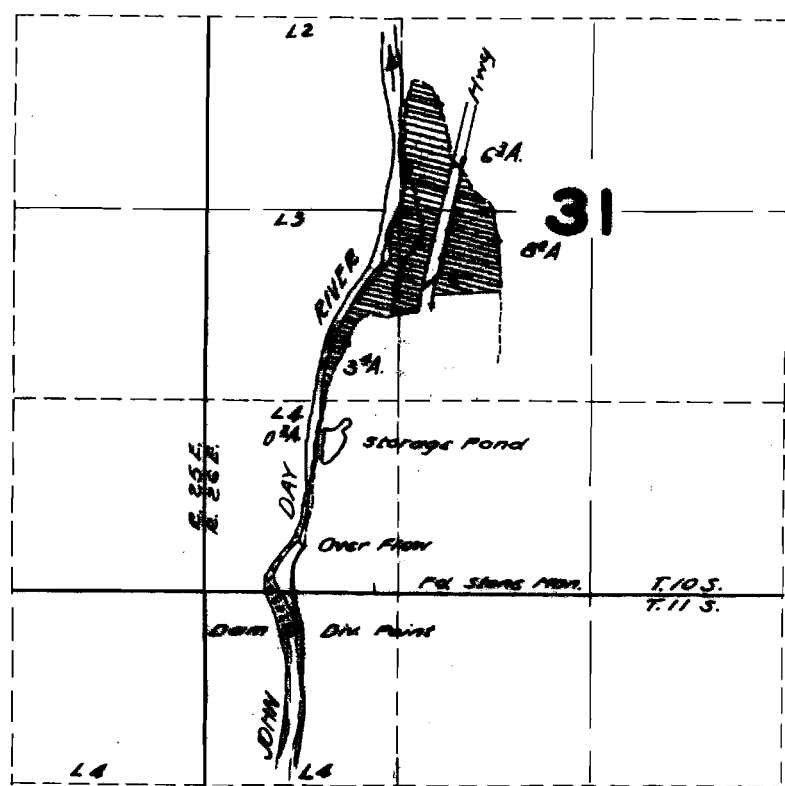

FINAL PROOF SURVEY
UNDER

Application No. ~~21848~~ Permit No. ~~17226~~
IN NAME OF

W. J. FOREE

Surveyed OCT. 30, 1949, by H. L. COFFMAN.