


T.21S.R.2W.W.M.

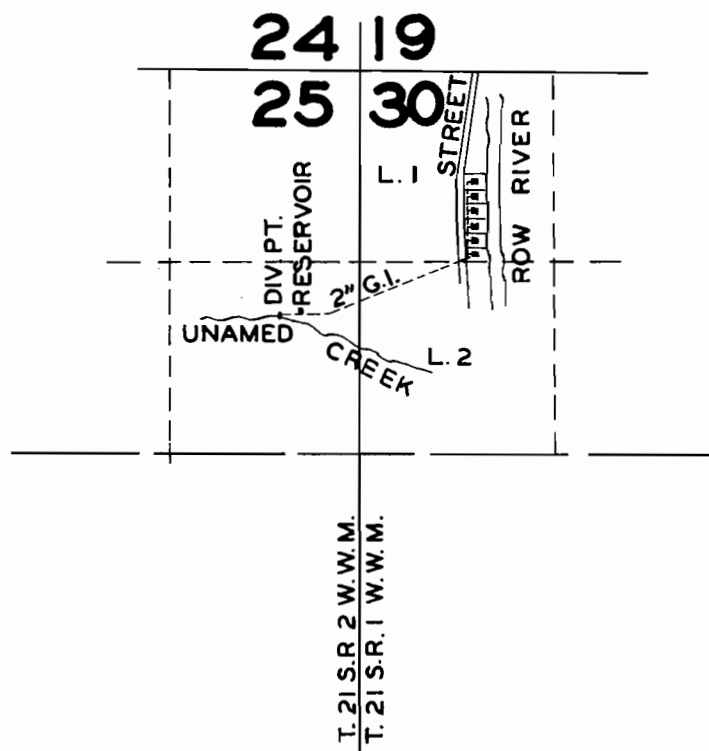

FINAL PROOF SURVEY
UNDER

Application No. 21948. Permit No. 17269.
IN NAME OF

BOOTH KELLEY LBR. CO.

Surveyed JUNE 9 1949, by H.L. COFFMAN.