


T.30S.R.6W.W.M.

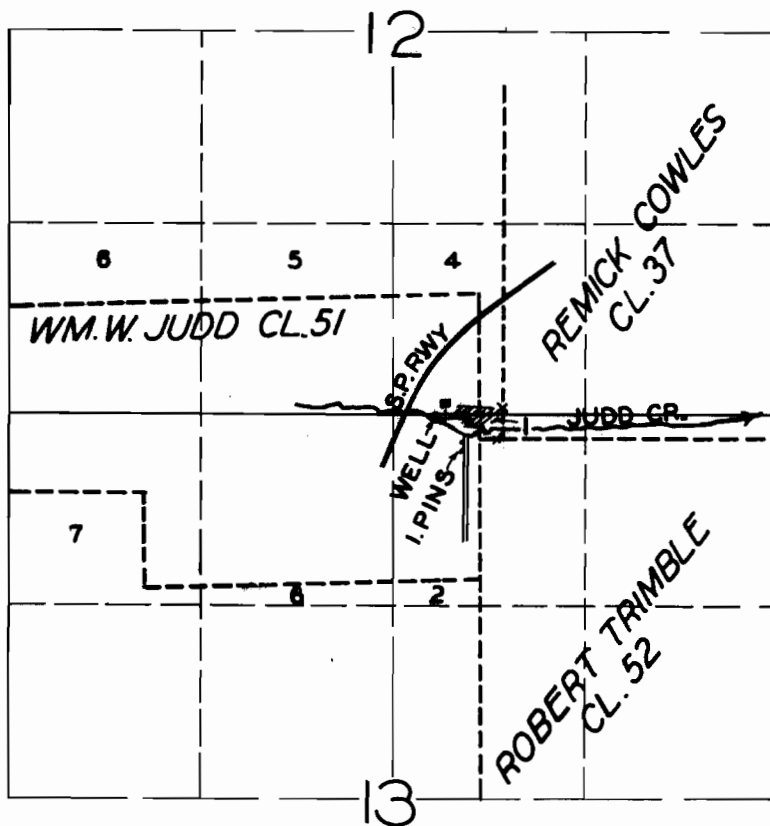

FINAL PROOF SURVEY

UNDER

Application No. 22100... Permit No. 17372...

IN NAME OF

ROY ADSIT

Surveyed JUL. 27 1949, by H.L. COFFMAN