


**T. 26 S.R. 6 W.W.M.**

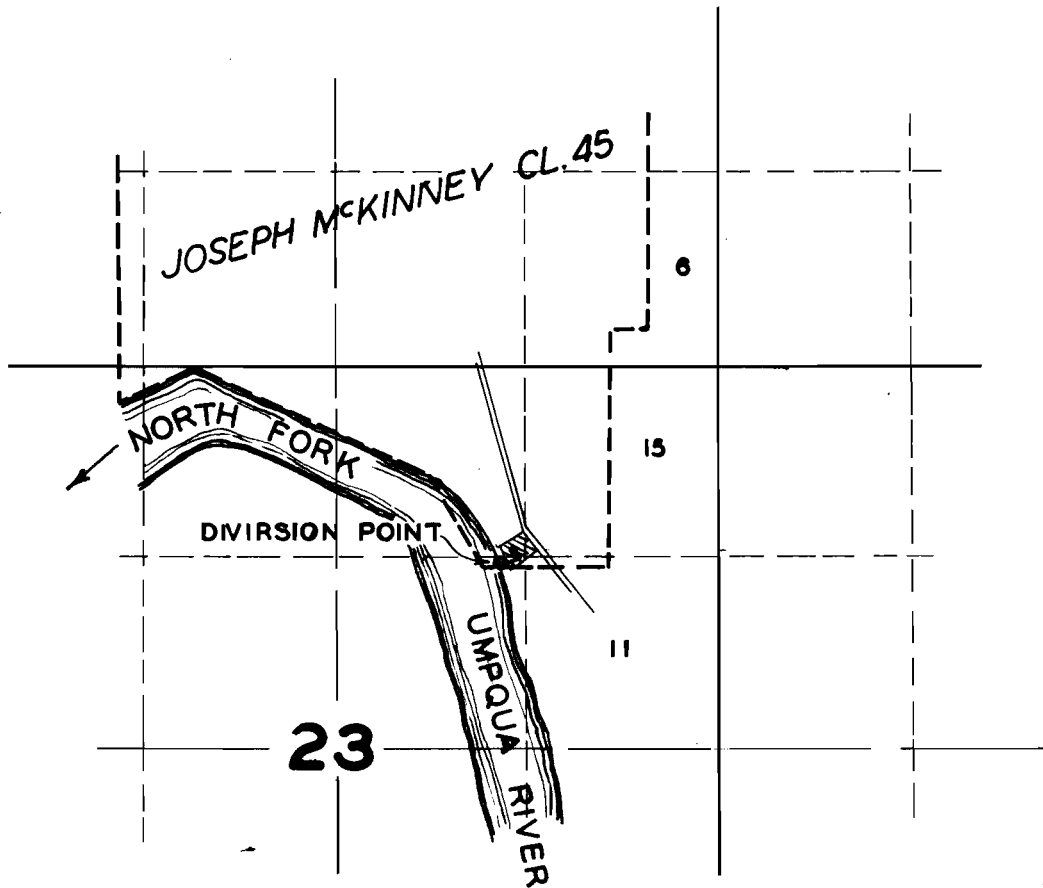

**FINAL PROOF SURVEY**  
UNDER

Application No. 21957... Permit No. 17273.  
IN NAME OF

**WALTER LEDMONDS**

Surveyed 6/29 1949, by H.L. COFFMAN