


**T.24S.R.13W.W.M.**

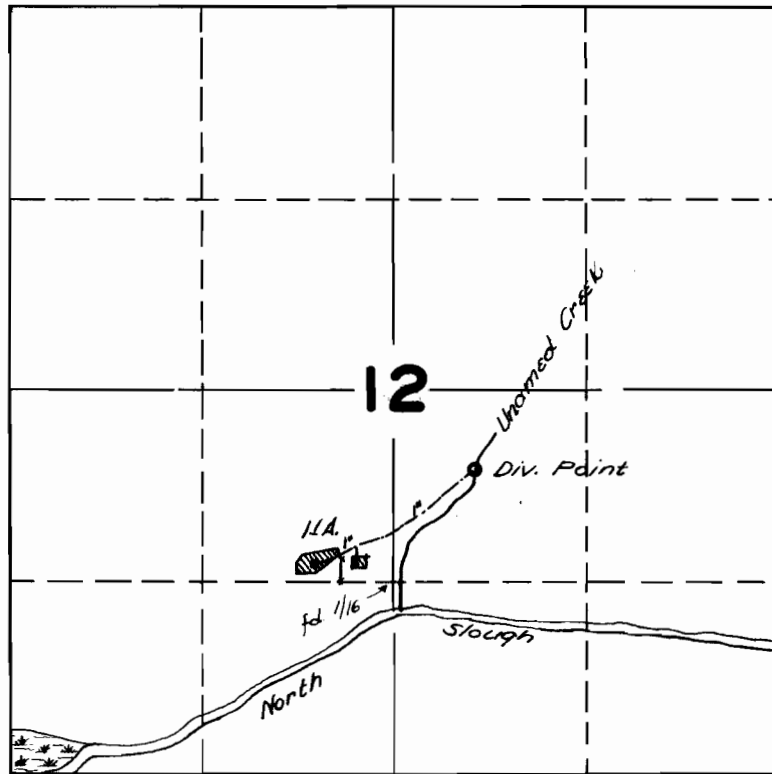

**FINAL PROOF SURVEY**

UNDER

Application No. 21977... Permit No. 17283...

IN NAME OF

.....G. WILLIS PETERSON.....

Surveyed AUG. 19, 1949, by H.L. COFFMAN.