


T.27S.R.13W.W.M.

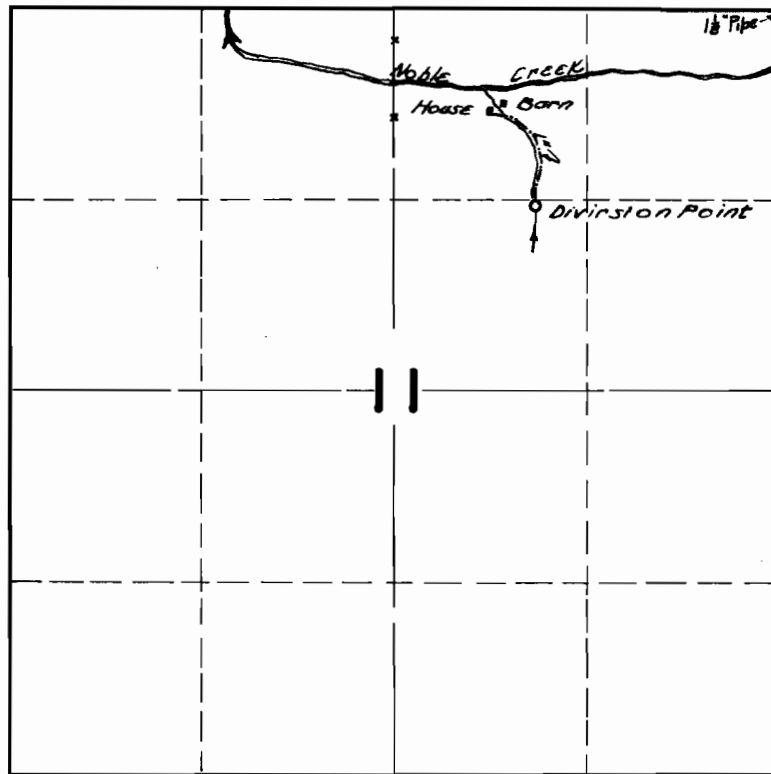

FINAL PROOF SURVEY
UNDER

Application No. 22010. Permit No. 17301....
IN NAME OF

ROBERT AND NORINE ESSELSTROM

Surveyed SEPT. 19 1949, by H.L. COFFMAN.