


**T. 26 S. R. 12 W. M.**

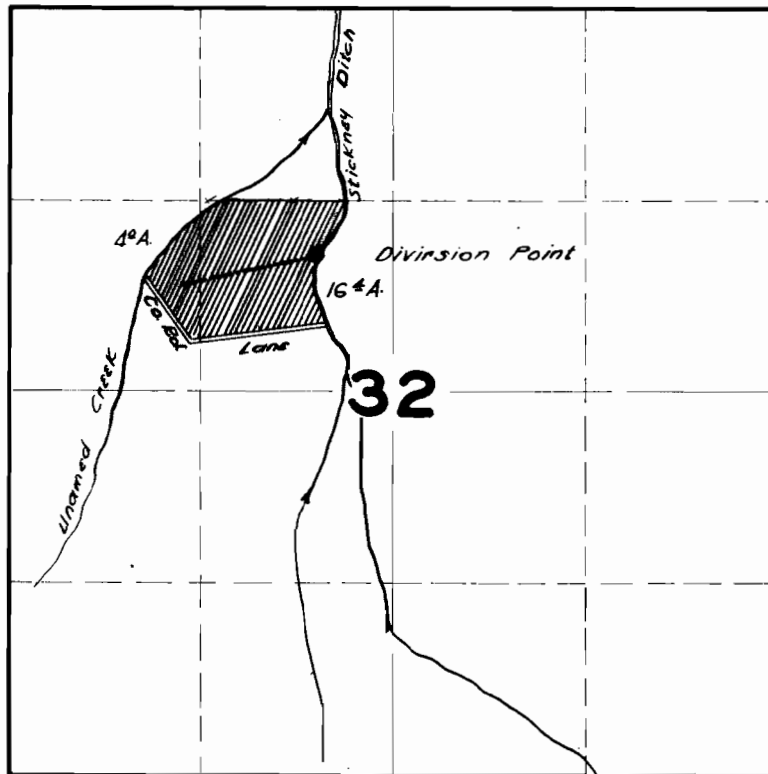

**FINAL PROOF SURVEY**  
UNDER

Application No. **22150**. Permit No. **17443**.  
IN NAME OF

**DONALD R. GRAY**

Surveyed **SEP. 9**, 1949, by **H.L. COFFMAN**.