


T.26S.R.7&6W.W.M.

ROSEBURG HOME ORCHARD
TRACTS

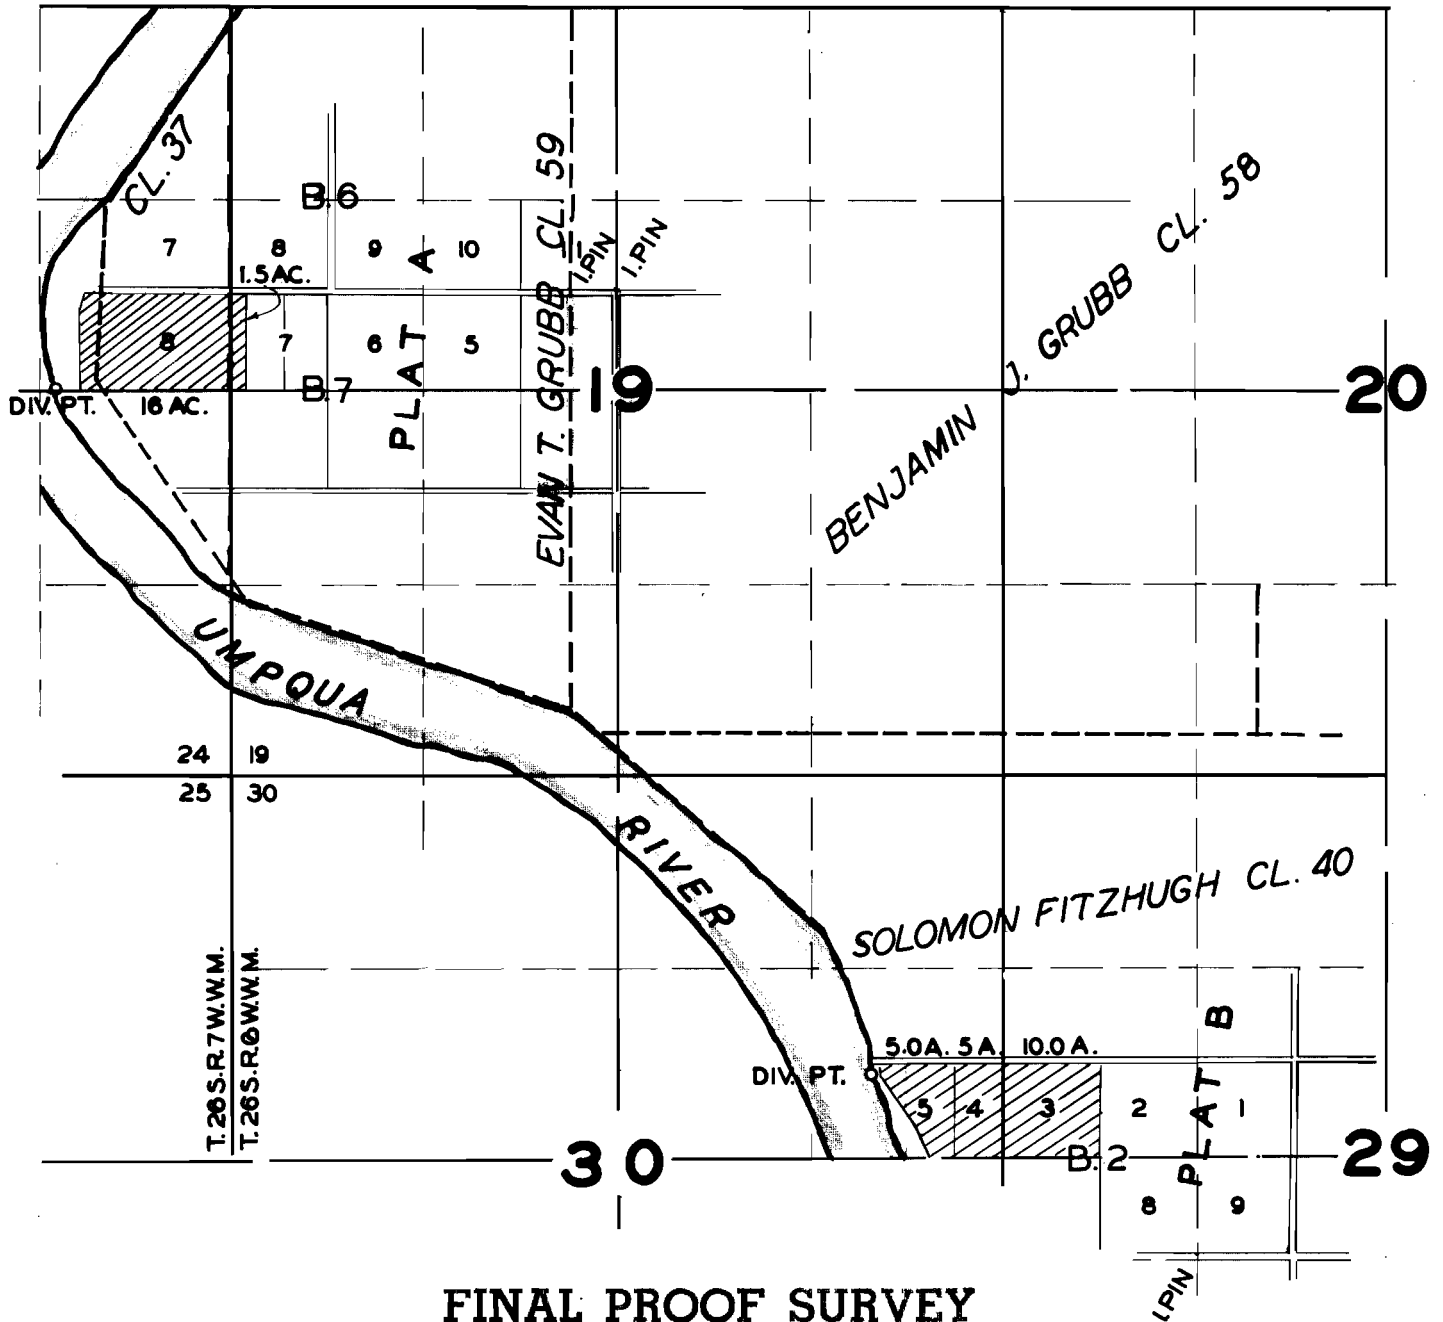

FINAL PROOF SURVEY UNDER

Application No. **22276** Permit No. **17509**
IN NAME OF

J. GLIFFORD HESS

Surveyed JULY 5, 19... by H.L. COFFMAN