


# T.16S.R.2W.W.M.

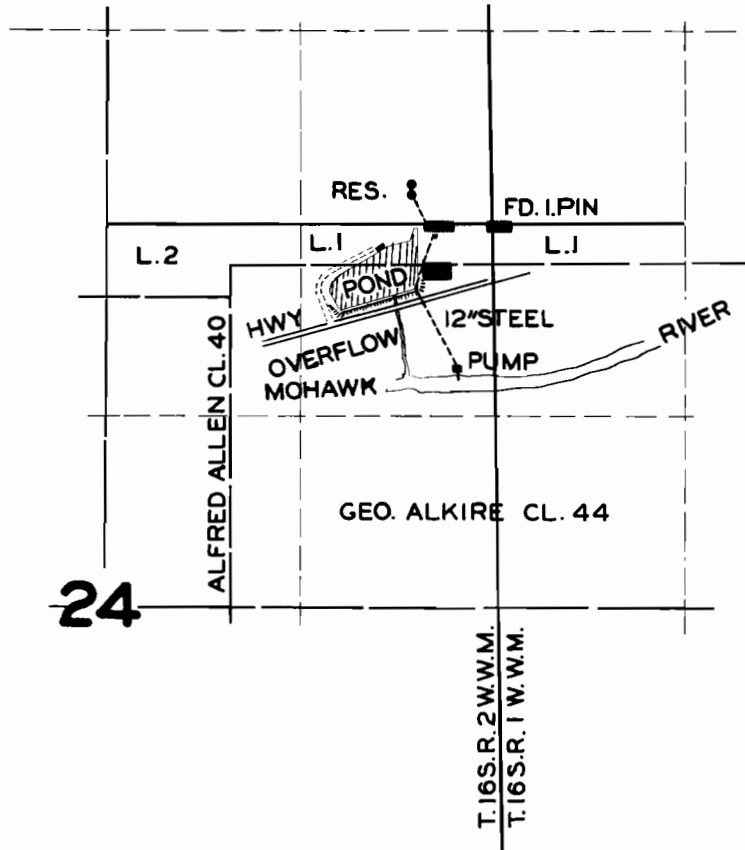

## FINAL PROOF SURVEY UNDER

Application No. 22063. Permit No. 17524.  
IN NAME OF

FISCHER LUMBER CO.

Surveyed JUNE 6, 1949, by H.L. COFFMAN