


T. 9S. R. 28E. W.M.

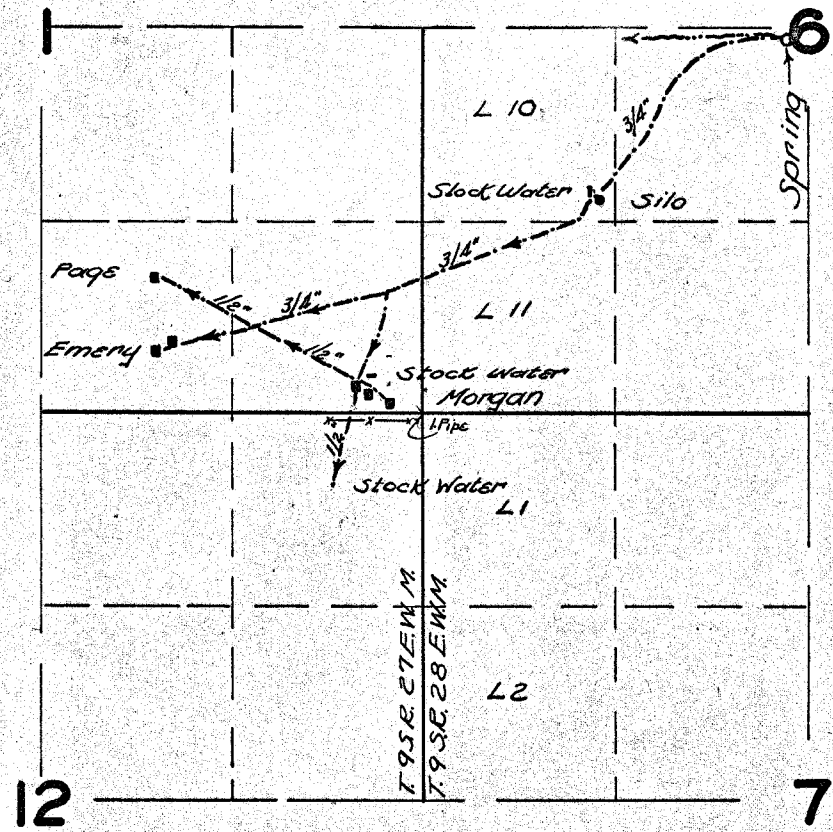

FINAL PROOF SURVEY

UNDER

Application No. 22392 Permit No. 17651...
IN NAME OF

CHLOE M. PAGE

Surveyed OCT. 28 1949., by H.L. COFFMAN