


T.26S. R.3 W.W.M.

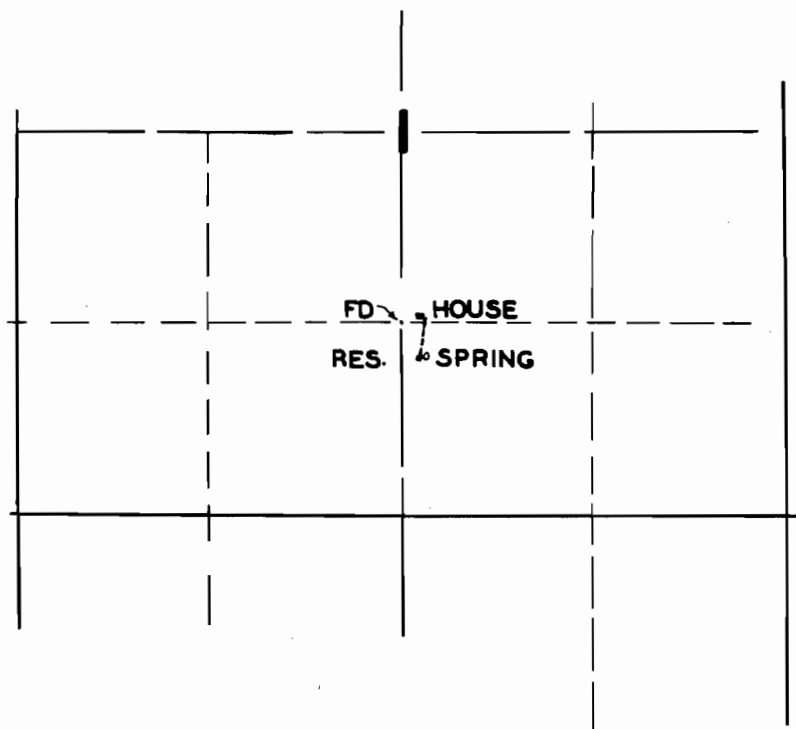

FINAL PROOF SURVEY
UNDER

Application No. **22018**. Permit No. **17690**...
IN NAME OF

.....**L. H. NIXON**.....

Surveyed **JULY 8 1949**, by **H. L. COFFMAN**