


T20 S.R.1W.W.M.

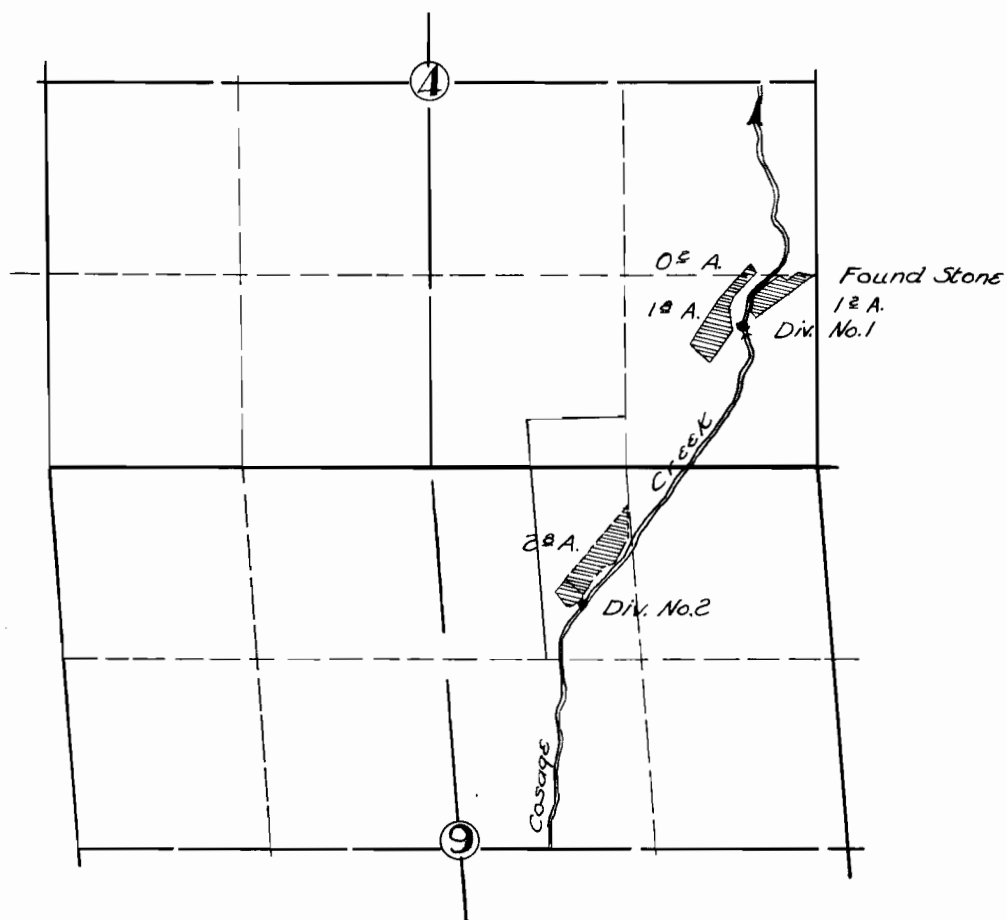

FINAL PROOF SURVEY
UNDER

Application No. 22491 Permit No. 17731
IN NAME OF

LOUIS JOBANEK

Surveyed June 3, 1949, by H.L. Coffman