


T.27S.R.13W.WM.

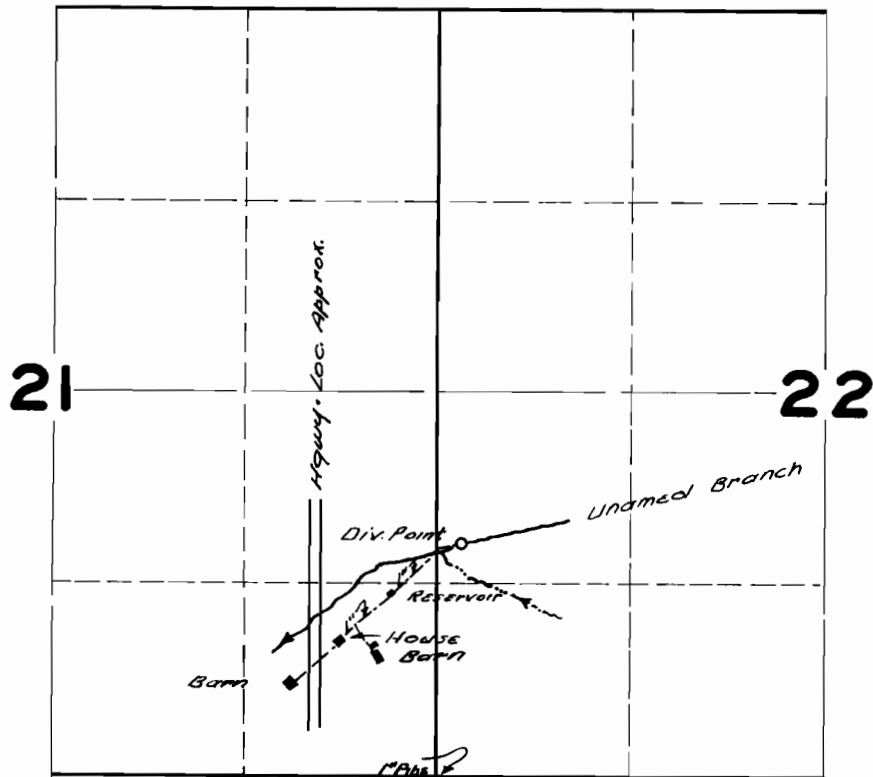

FINAL PROOF SURVEY

UNDER

Application No. **19771**..... Permit No. **15355**..

IN NAME OF

ROSE H. GARRETT

Surveyed **SEPT. 19 1949.**, by **H. L. COFFMAN**..