


# T.16S.R.2E.W.M.

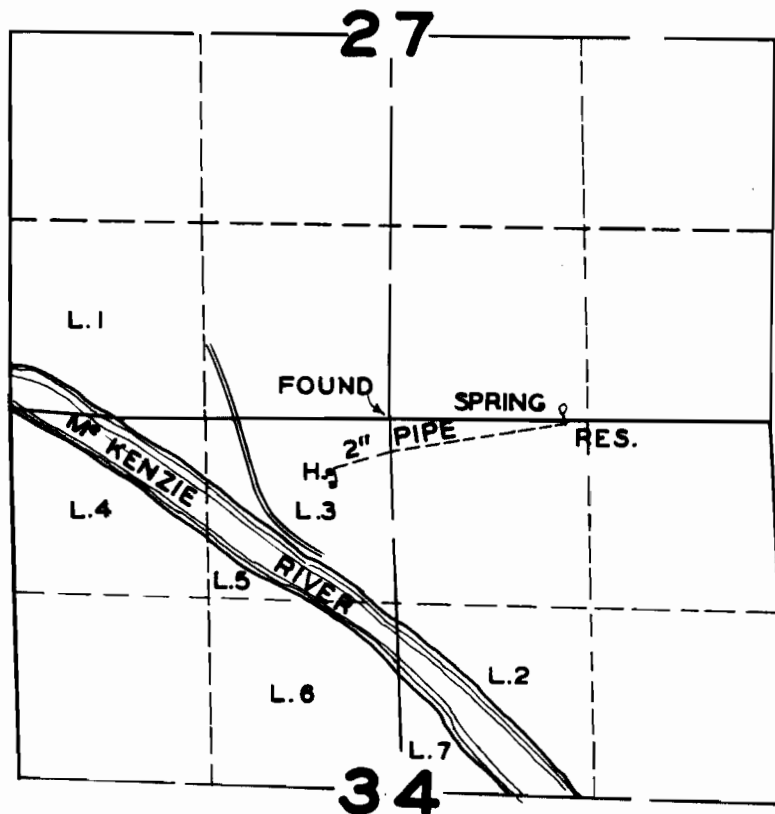

## FINAL PROOF SURVEY UNDER

Application No. 20588. Permit No. 16088.  
IN NAME OF

WOODROW W. DONOHO

Surveyed 6/22, 1949, by H.L. COFFMAN