


T.28S.R.7W.W.M.

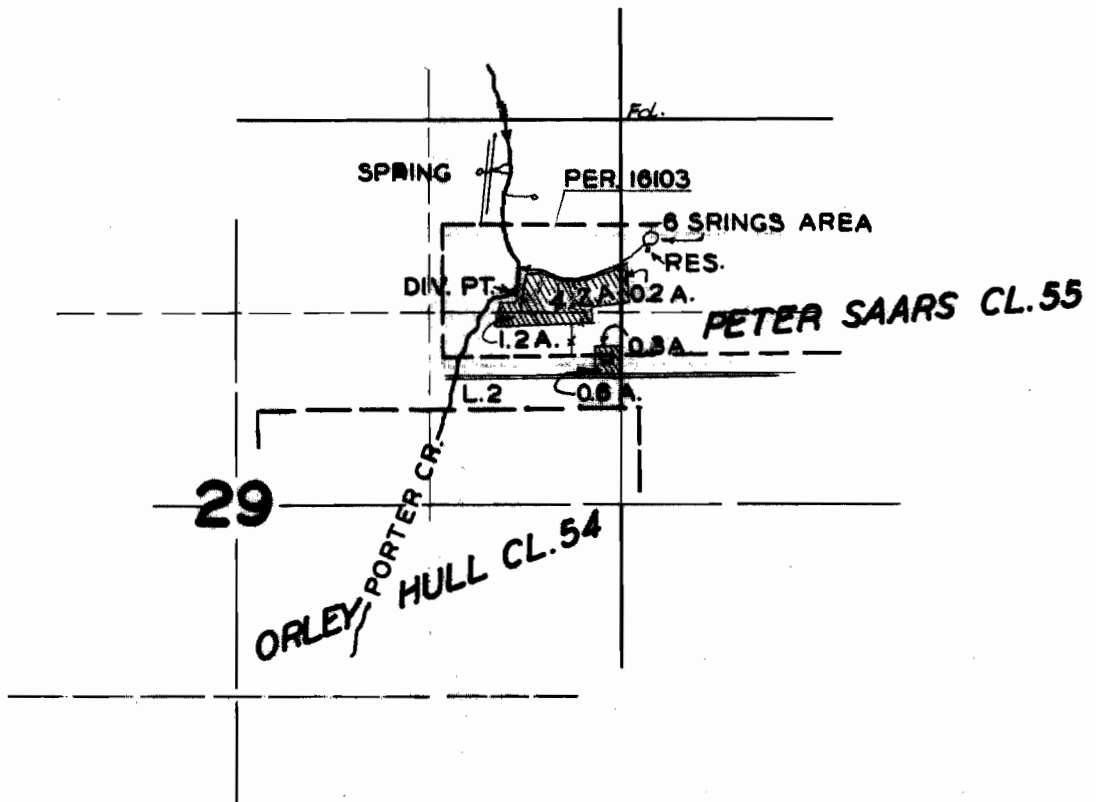

FINAL PROOF SURVEY
UNDER

Application No. 22649 Permit No. 17799
IN NAME OF

JAMES A. HENRY

Surveyed JULY 7 1949, by H.L. COFFMAN