


T.25S. R.5W.W.M.

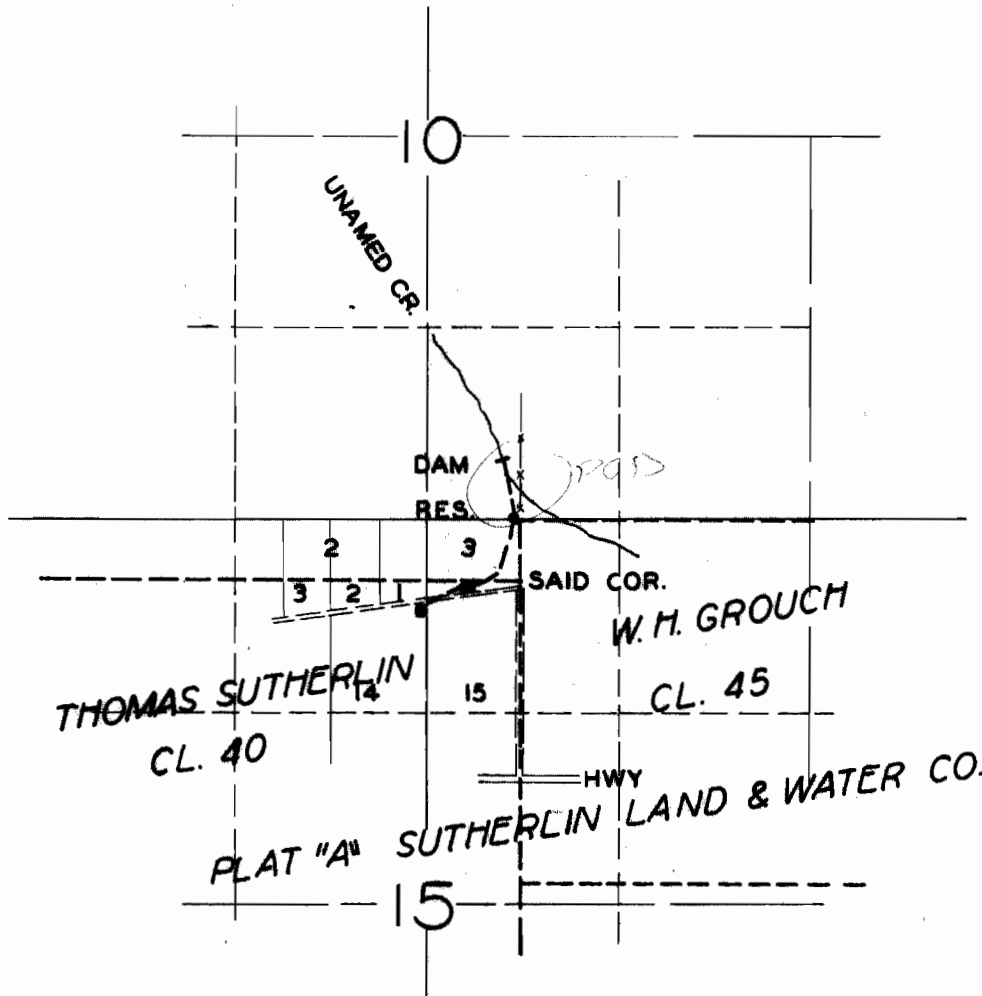

FINAL PROOF SURVEY UNDER

Application No. 22653. Permit No. 17800...
IN NAME OF

.....WILLIAM J. WEBBER.....

Surveyed JULY 19, 1949., by H.L. COFFEMAN