


T.19S.R.1W.W.M.

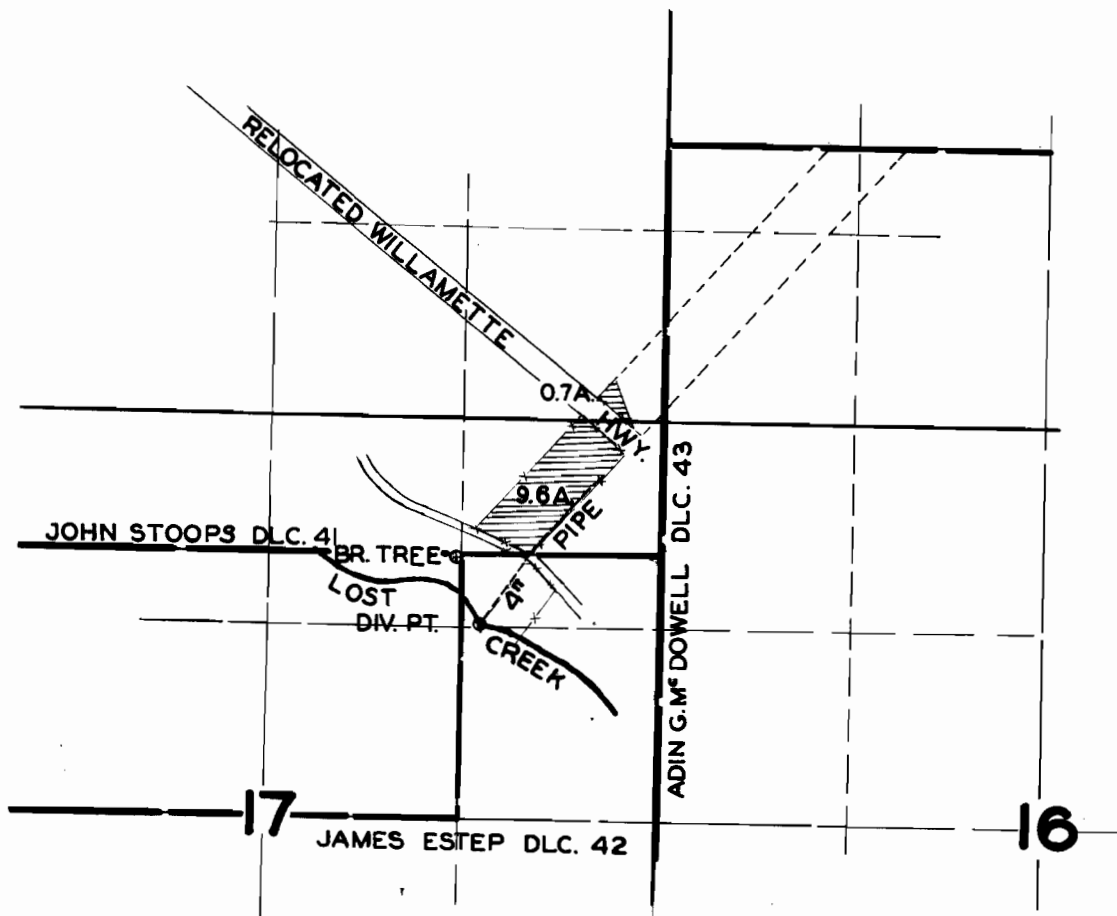

FINAL PROOF SURVEY

UNDER

Application No. 22569 Permit No. 17824

IN NAME OF

TOM O. RILEY

Surveyed JUNE 1, 1949, by H.L. COFFMAN