


T. 15 S. R. 16 E. W.M.

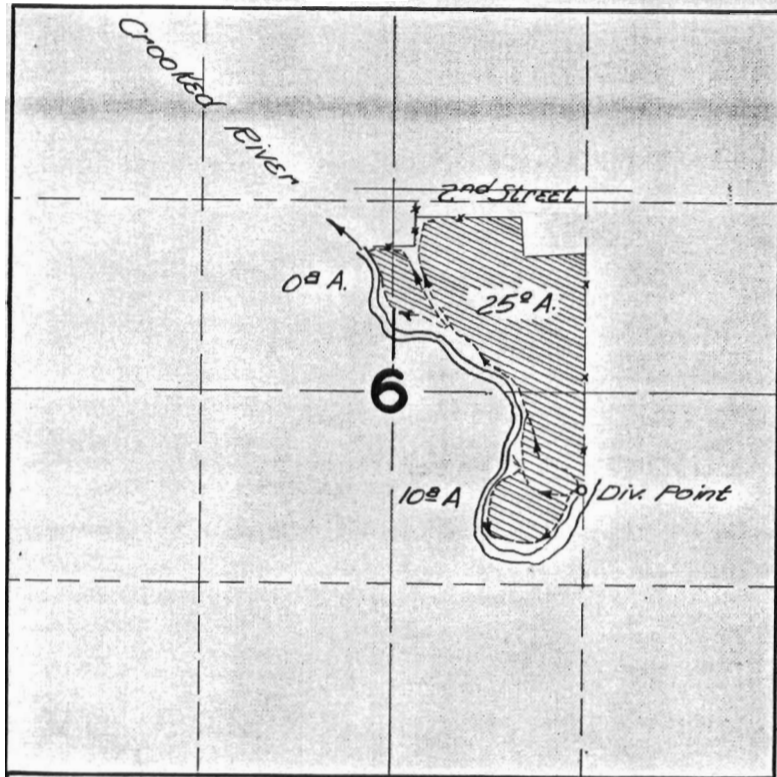

FINAL PROOF SURVEY

UNDER

Application No. 22677.. Permit No. 17836..

IN NAME OF

H.J. LAU

Surveyed OCT. 13. 1949, by H.L. COFFMAN

P # 17836

1949 H