


T.18S.R.4W.W.M.

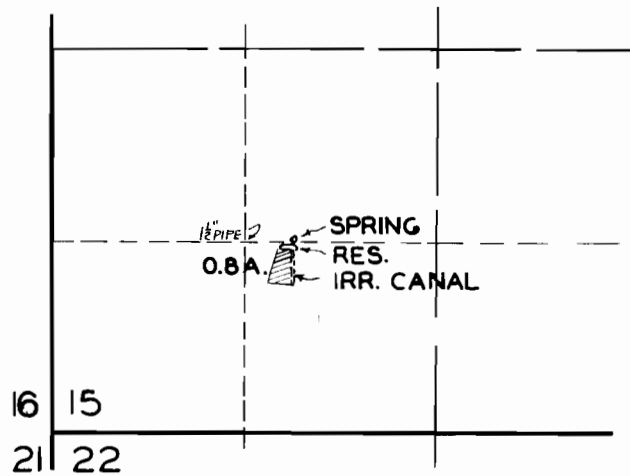

FINAL PROOF SURVEY

UNDER

Application No. 22726 Permit No. 17856

IN NAME OF

TRUMAN & NELLIE B. WILLS

Surveyed MAY 26 1949, by H.L. COFFMAN