


T.20S.R.3W.W.M.

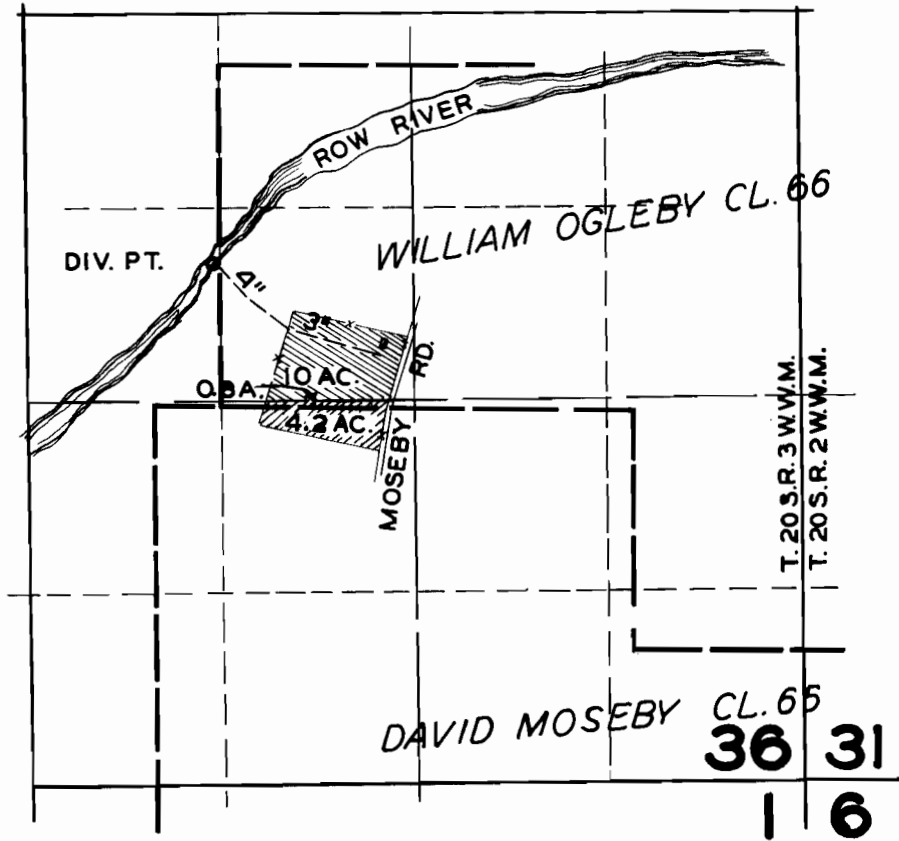

FINAL PROOF SURVEY

UNDER

Application No. 22630. Permit No. 17920

IN NAME OF

C.W. RAYMOND

Surveyed JUNE 21 1949, by H.L. COFFMAN.