


T. 26 S.R. 6 W.W.M.

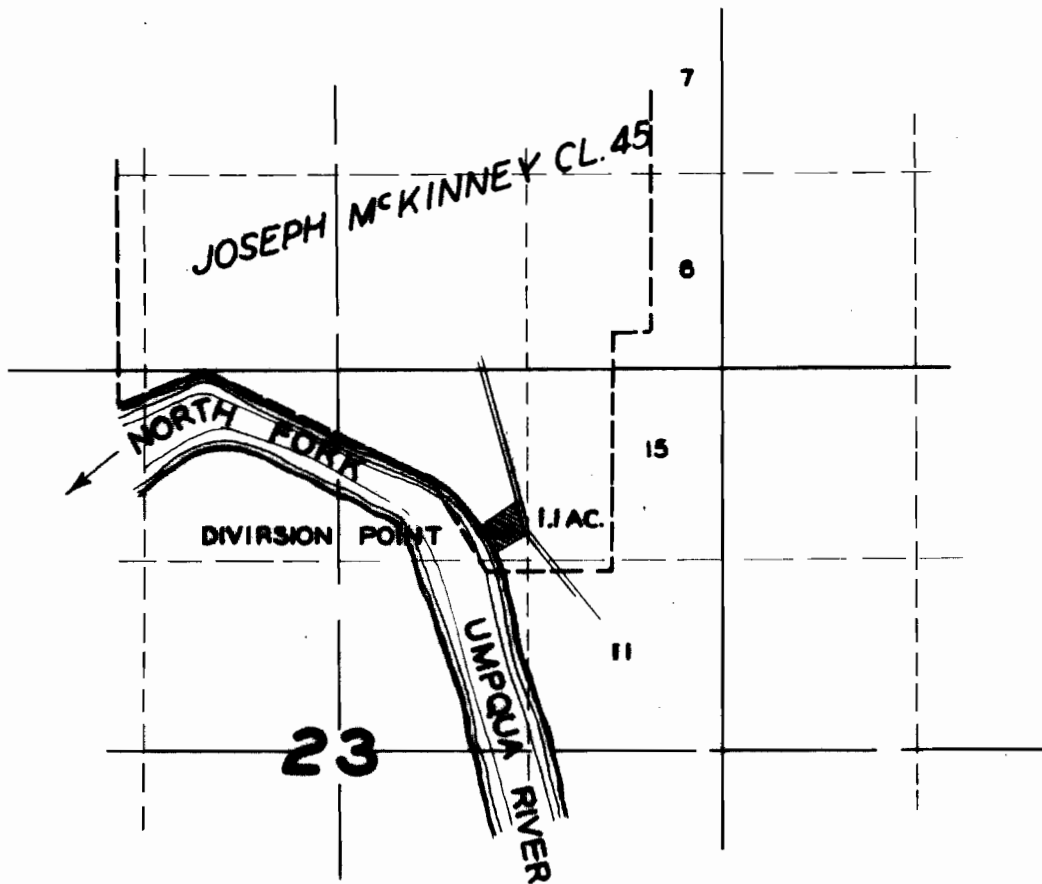

FINAL PROOF SURVEY

UNDER

Application No. 22896 Permit No. 18000.

IN NAME OF

..... L. E. SHINN

Surveyed 6/29 1949, by H. L. COFFMAN