


Per 18205  
17372

# T.14S. R.31E. W.M.

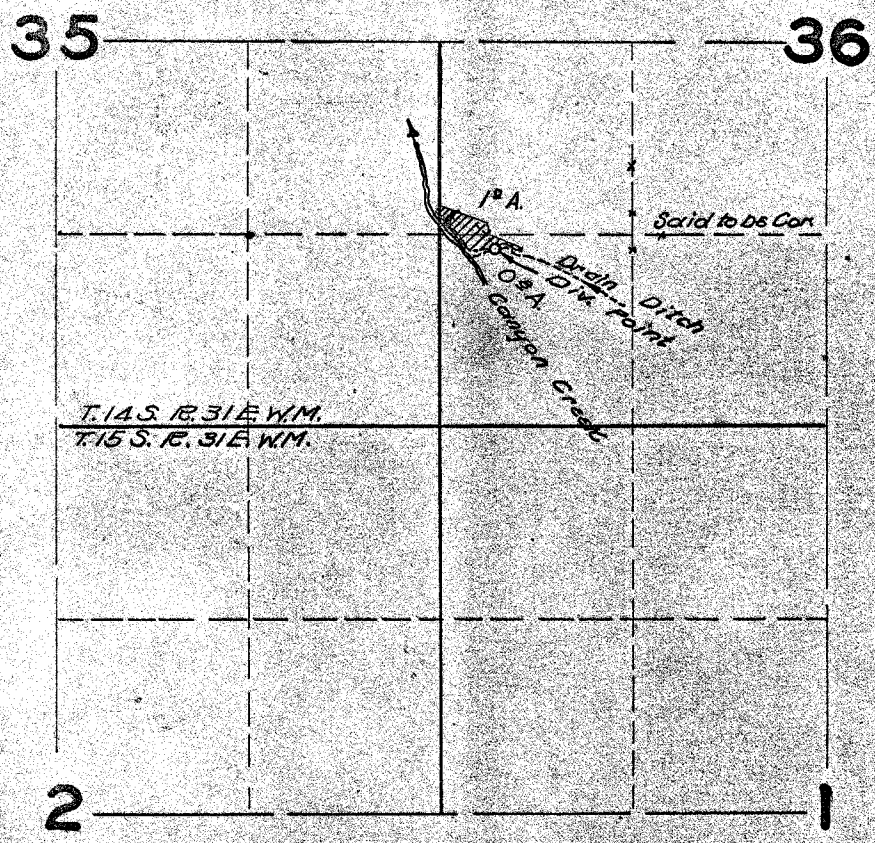

T.14S. R.31E. W.M.  
T.15S. R.31E. W.M.

## FINAL PROOF SURVEY UNDER

Application No. 23069 Permit No. 18205.  
IN NAME OF

JESS T. ILER

Surveyed OCT. 20 1949, by H.L. COFFMAN