


T.29S.R.12W.W.M

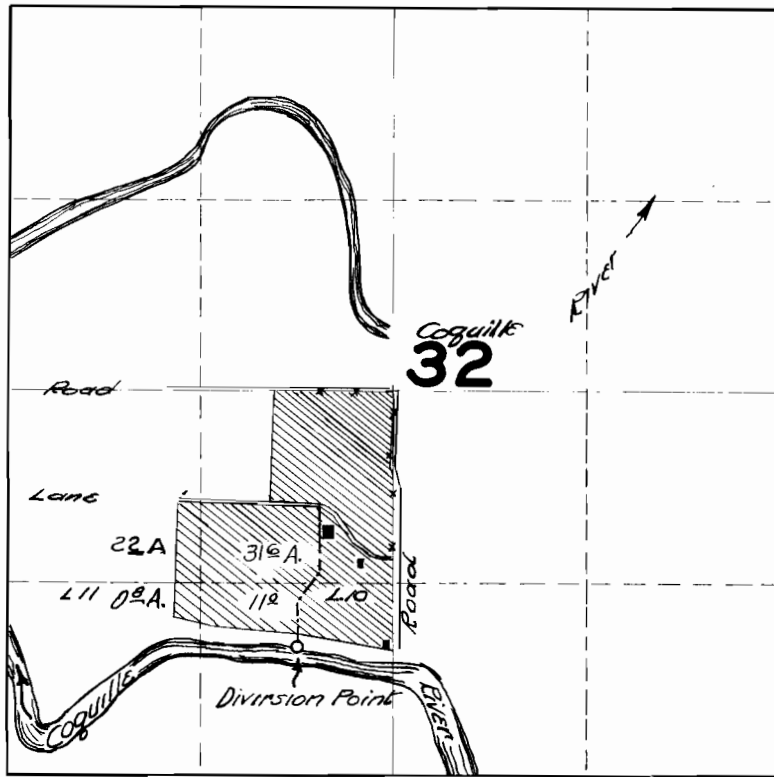

FINAL PROOF SURVEY

UNDER

Application No. **22714**... Permit No. **18027**...

IN NAME OF

E.L. CLAUSEN

Surveyed **SEPT. 14 1949**, by **H.L. COFFMAN**...