


# T. 6S. R. 1W.W.M.

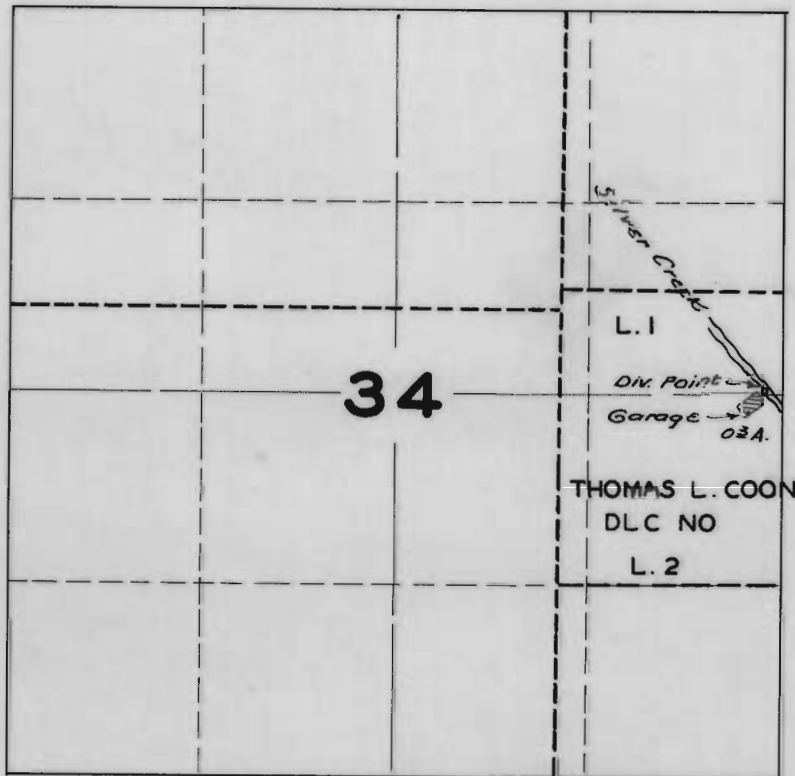

## FINAL PROOF SURVEY UNDER

Application No. **23123**. Permit No. **18224**.  
IN NAME OF

**HARRY L. RICHES**

Surveyed NOV. 8, 1949, by H. L. COFFMAN.