


T.28S.R.7W.W.M.

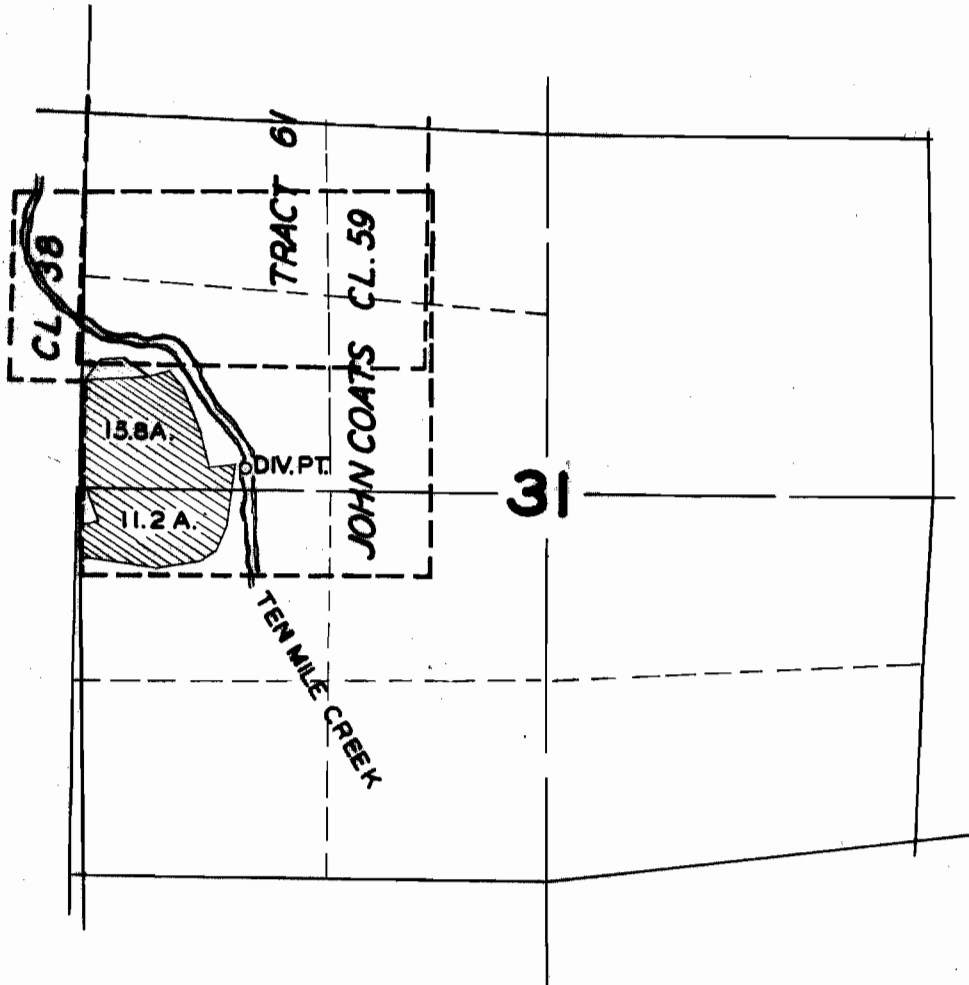

FINAL PROOF SURVEY

UNDER

Application No. 23005 Permit No. 18104
IN NAME OF

HARRY GOODELL

Surveyed JULY 6, 1949, by H.L. COFFMAN