


LOT NO. 7
VACATED ORCHARD HILL
T.2S.R.1E.W.M.

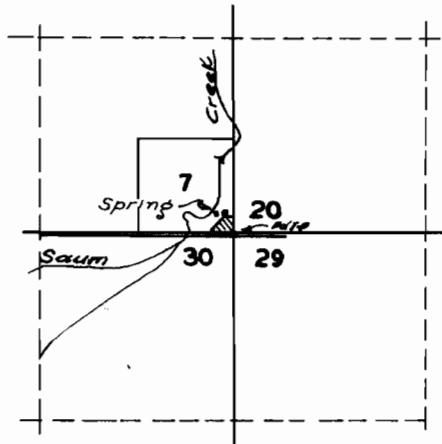

FINAL PROOF SURVEY
UNDER

Application No. 23314... Permit No. 18387...
IN NAME OF

.....CARL L. ELLIGSEN.....

Surveyed MAY 15, 1949, by H.L. COFFMAN