


Sec. 4

T. 40 S., R. 4 E W.M.

18409

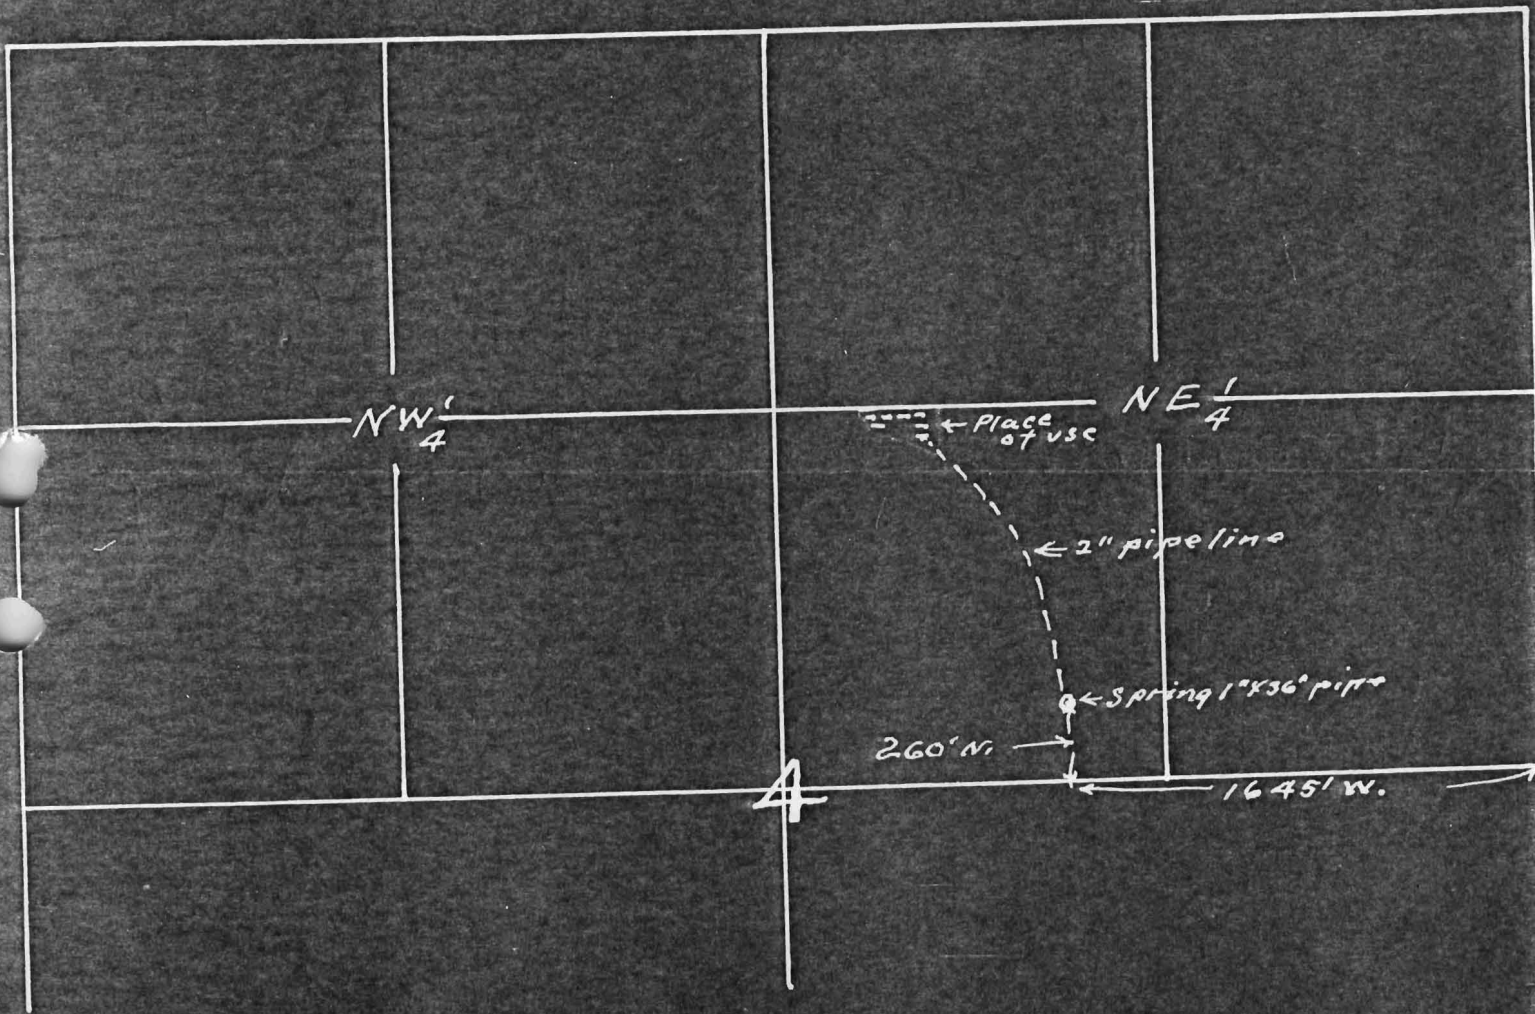

Map to accompany application of
Jack Marcellino for use of water
from spring for domestic, Cafe
and service station purposes.

This office 9/15/48 *W. Smith*

Application No. 23426
Permit No. 18409

23426

14-4

17380

Jenny C. Mac