


T.2 | S. R. | W.W.M.

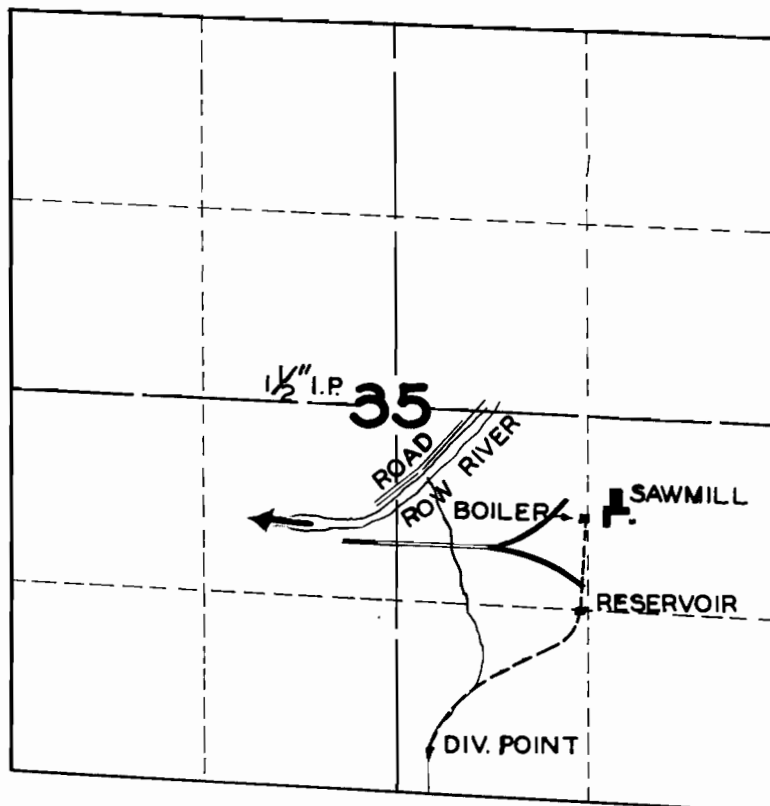

FINAL PROOF SURVEY
UNDER

Application No. **23452** Permit No. **18506**
IN NAME OF

WHEELER, OSCOOD CO.

Surveyed **JUNE 15 1949**, by **H.L. COFFMAN**